


T.13S.R.9E.W.M.

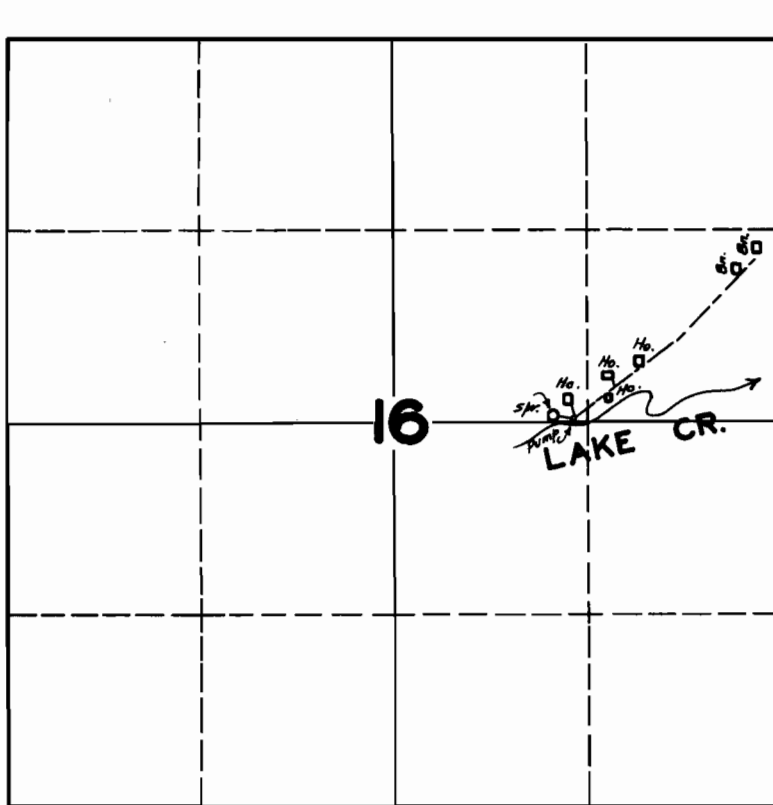

**FINAL PROOF SURVEY**  
UNDER

Application No. 19819 Permit No. 15424

IN NAME OF

D. L. CARPENTER & E. H. ROBBINS

Surveyed MAY 3 1946, by

*James B. Russell*