


T.21S.R.1 W.WM

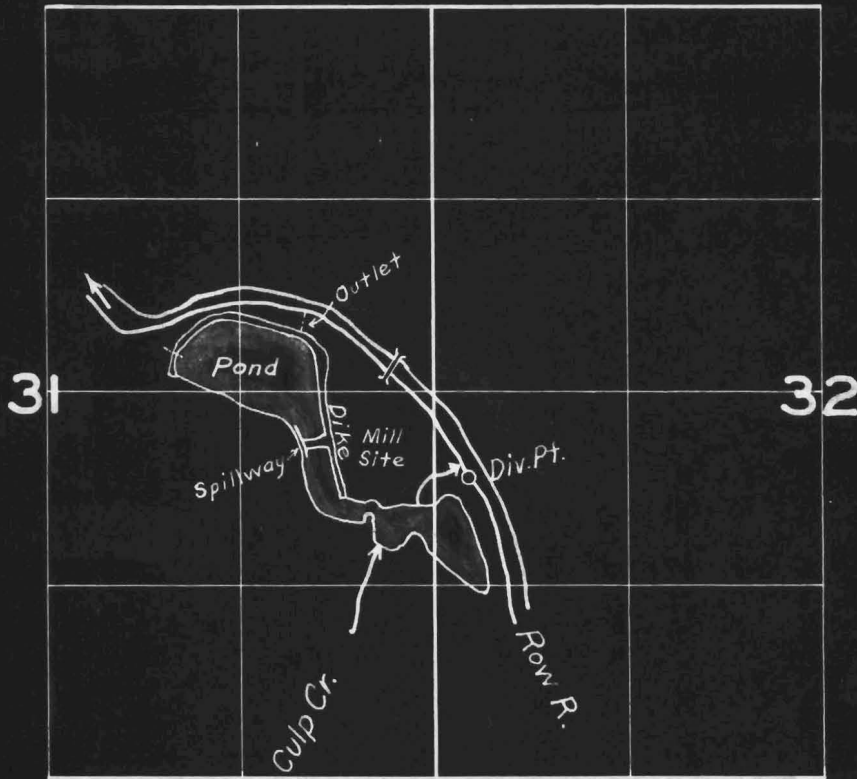

FINAL PROOF SURVEY

UNDER

R-25502
12915

8-1201
20169

Application No. 25570 Permit No. 20511

IN NAME OF

Bohemian Lumber Co., Inc

Surveyed May 4, 1954, by T. Jones