




# T.5S.R.IW.WM

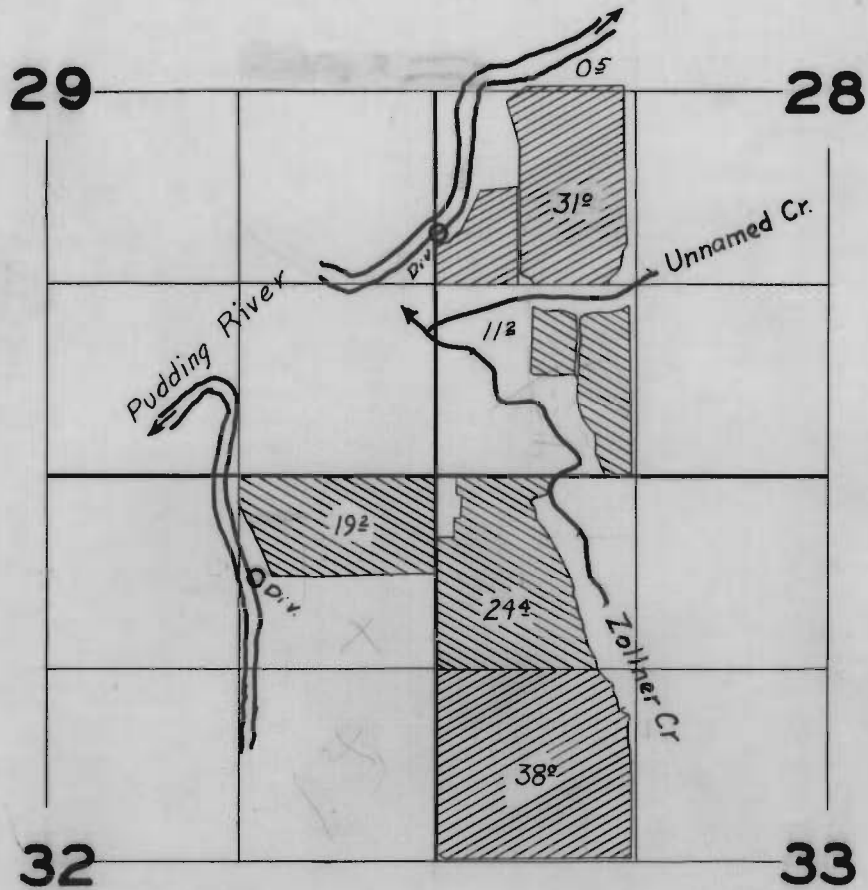

Appl. No. 25021   
 Appl. No. 20402 

## FINAL PROOF SURVEY

UNDER

Application No. 25021 Permit No. 19713 19713  
20402 15908 15908

IN NAME OF

Joe Obersimer

Surveyed May 20 1954, by H. L. Coffman