


T.3&4S.R.39E.WM

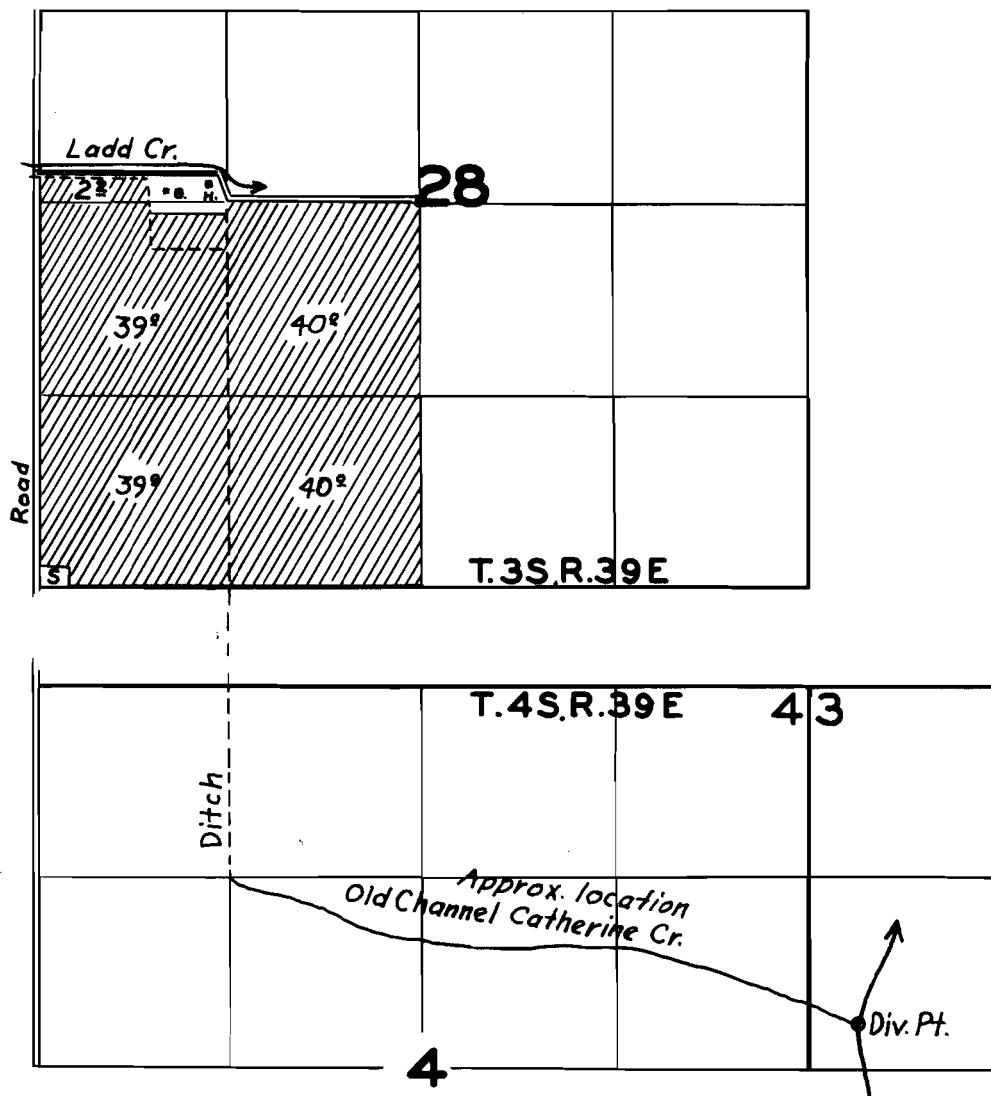

FINAL PROOF SURVEY UNDER

Application No. 20610..... Permit No. 16112.....
IN NAME OF

Allen Courtright

Surveyed Oct 7 1953, by T. Jones