


T.6N.R.35E.W.M.

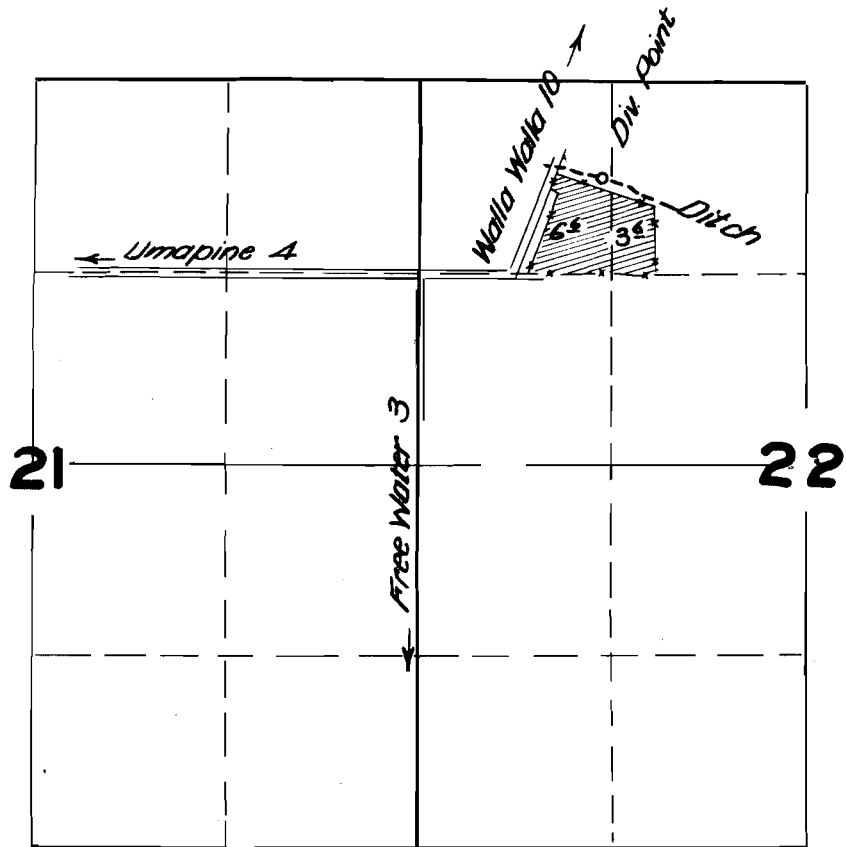

FINAL PROOF SURVEY
UNDER

Application No. 21541. Permit No. 16891.
IN NAME OF

FRANK J. PARENT

Surveyed OCT. 9, 1950, by H.L. COFFMAN