


C-22836 U-177
 C-20796 U-199
 C-20837 U-207
 C-24270 U-318

T. 6 N., R. 35 E., W.M.

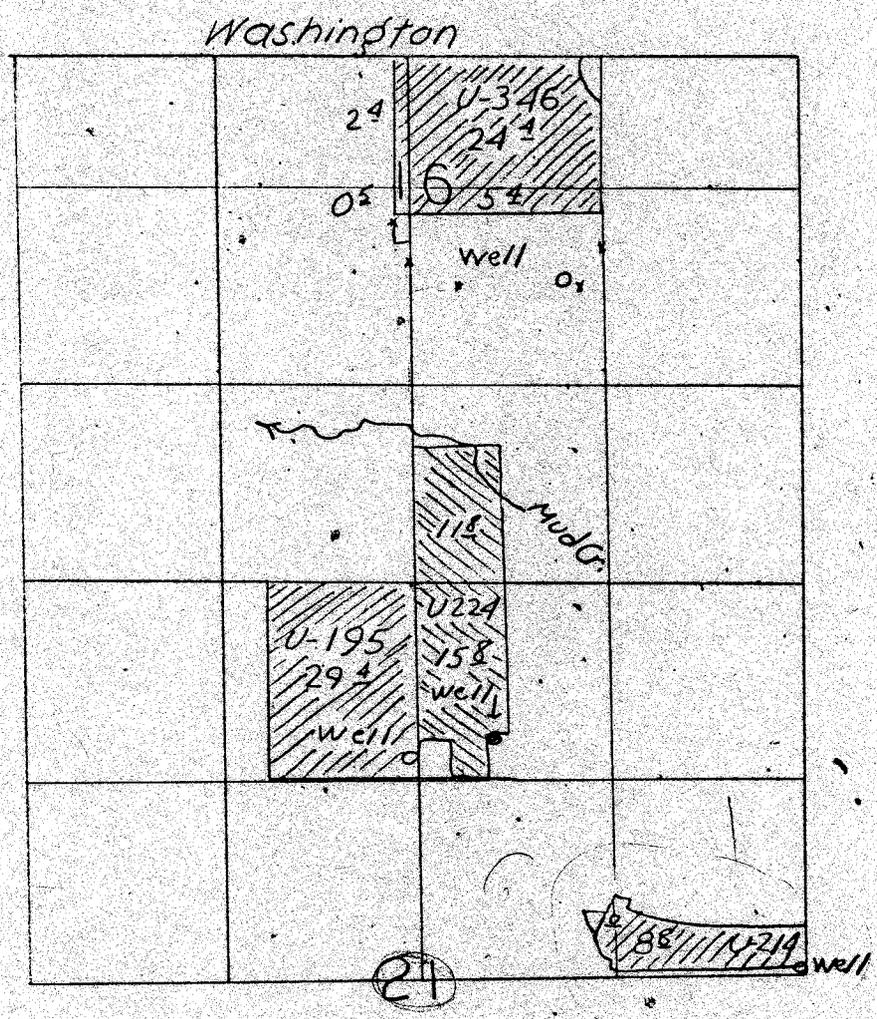

FINAL PROOF SURVEY

Name	Appl. No.	Permit No.
Mrs. Matilda Johnson	U-214	U-199
George E. Hogden	U-195	U-177
Walker C. Ellis + Berta P. Ellis	U-224	U-207
Lawrence + Maxine McBride	U-346	U-318

Copied in State Engineers Office