


T.2N. R.32E. WM

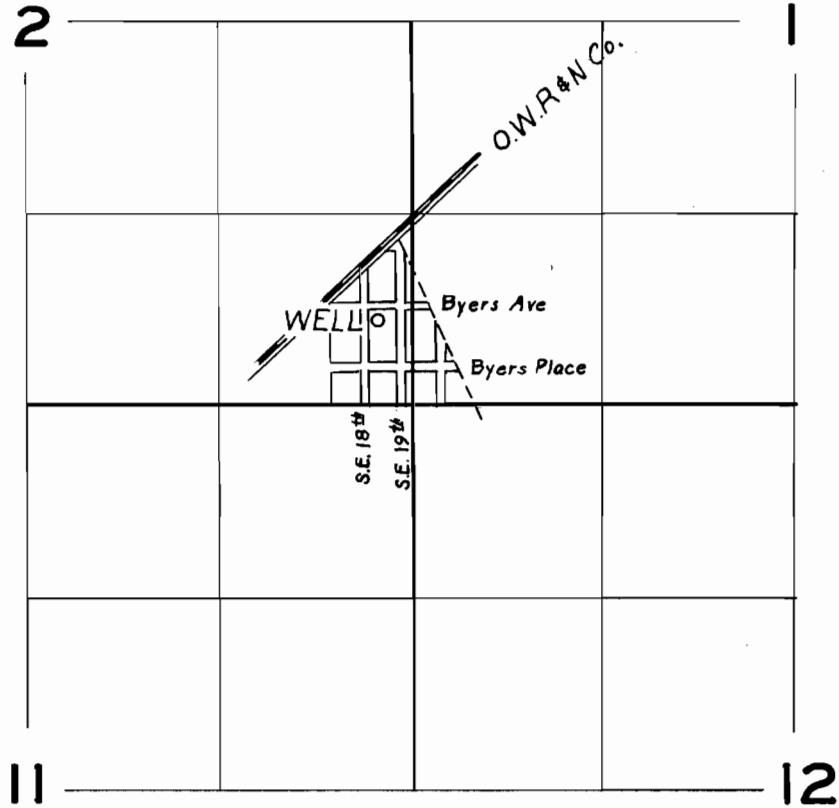

**FINAL PROOF SURVEY**  
UNDER

Application No. 1-158 Permit No. 0-152  
IN NAME OF

City of Wendleton Water Commission

Surveyed May 15 1951, by L. Jones