


T.4N.R.29E.WM

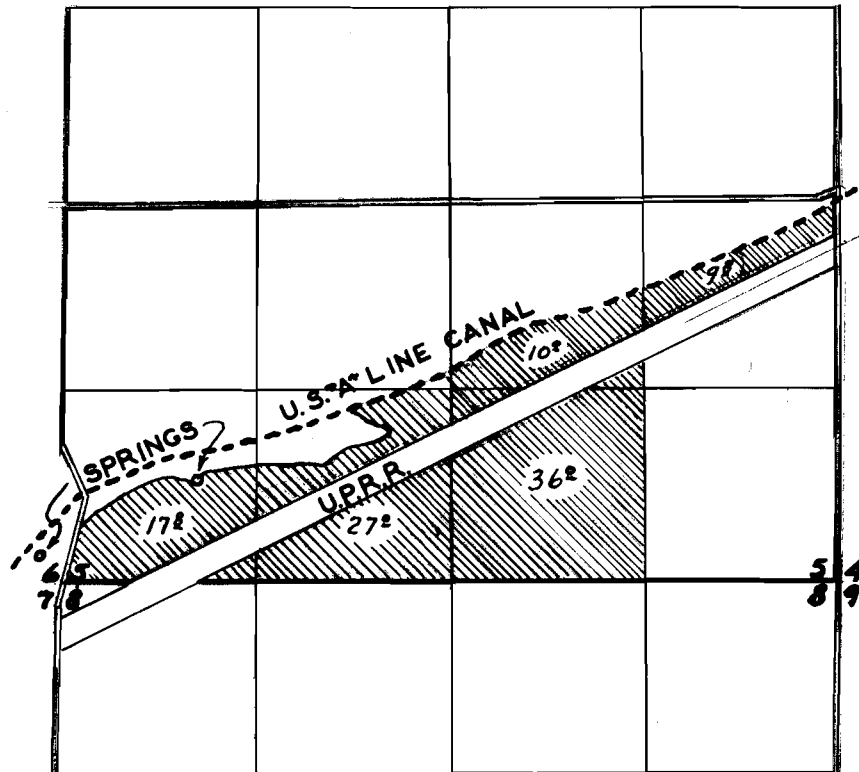

FINAL PROOF SURVEY

UNDER

Application No. 22169 Permit No. 17457

IN NAME OF

J. DELL CHRISTLEY

Surveyed Mar. 24, 1955, by M. Bennett