


T.35S.R.14 W.W.M.

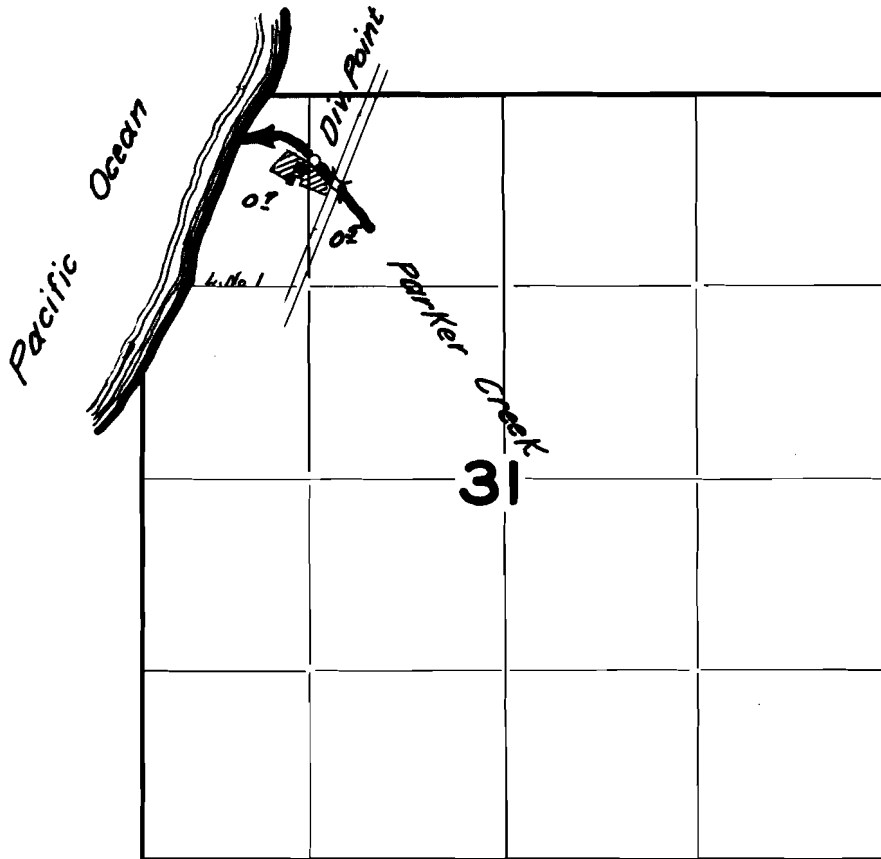

FINAL PROOF SURVEY

UNDER

Application No. 22255 Permit No. 17553

IN NAME OF

Emil A. & Ethil L. Nussbaumer

Benjamin C. & Leeta L. King, L.W. Lingacher

Surveyed Sept 15 1953, by H.L. Coffman

1953-D