


U-311
C-20848

T. 5 N., R. 35 E. W. M.

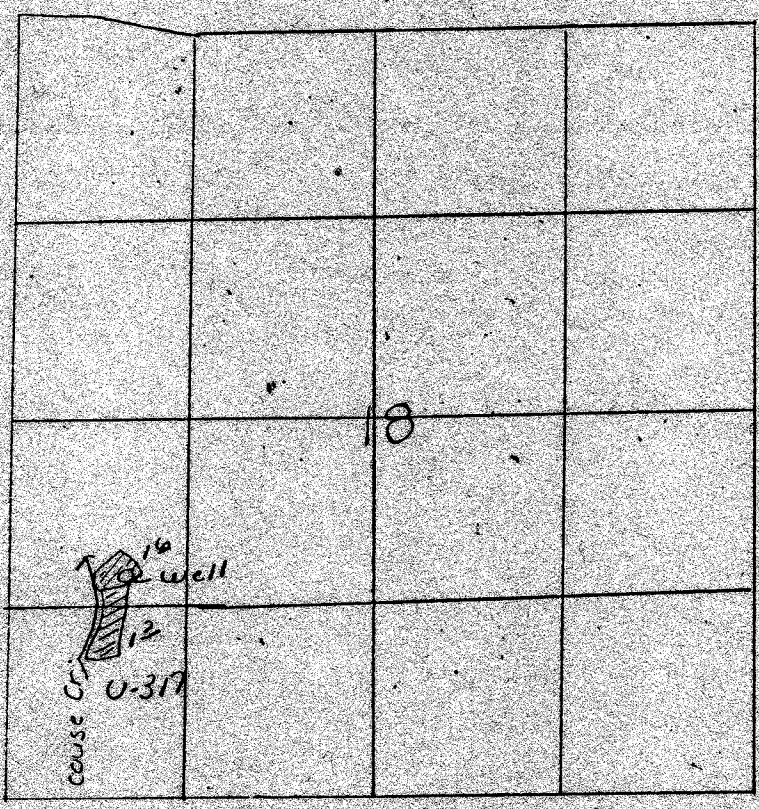

FINAL PROOF SURVEY

Appl. No. U-317 Permit No. U-311

Traced in State Engineer's office