


T.7S.R.3W.W.M.

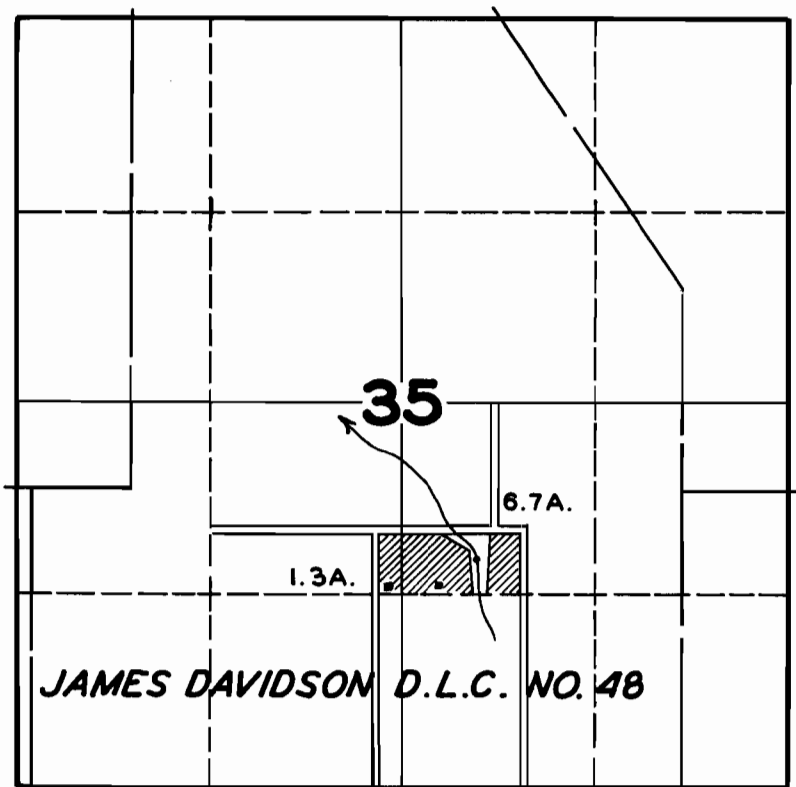

FINAL PROOF SURVEY
UNDER

Application No. **22386** Permit No. **17647**
IN NAME OF

GEORGE E. LONG

Surveyed **JUL. 16** 1948, by **JAS. E. BUNNELL**