


T.30S.R.15W.WM

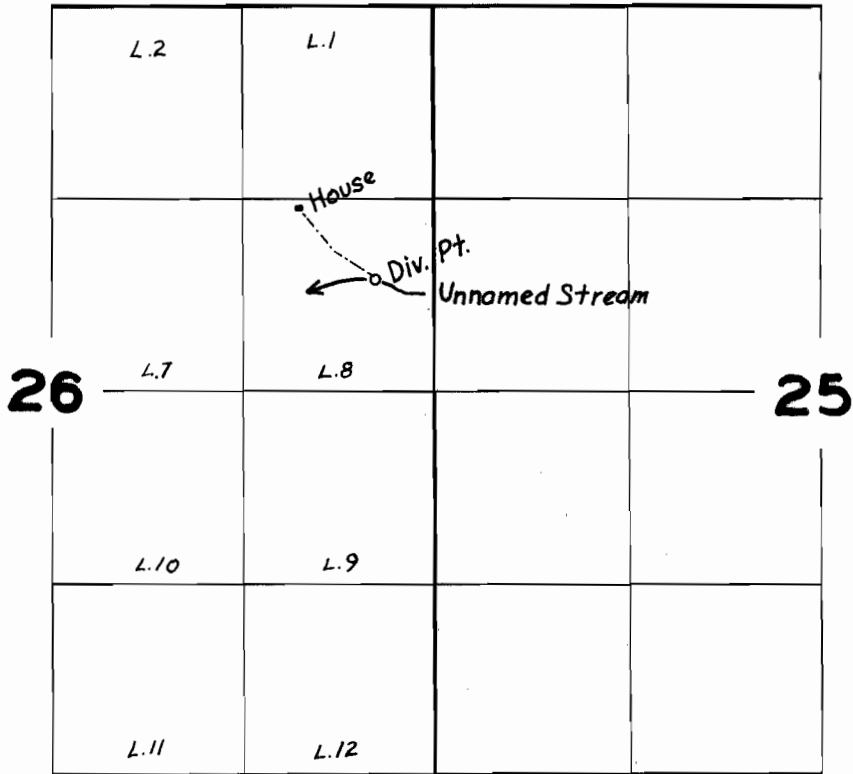

FINAL PROOF SURVEY UNDER

Application No. 22537..... Permit No. 17751.....
IN NAME OF

..... Donald W. Stryker

Surveyed Sept. 20, 1953, by T. Jones.....