


U-211
U-239
16894
18104

T. R. W.M.

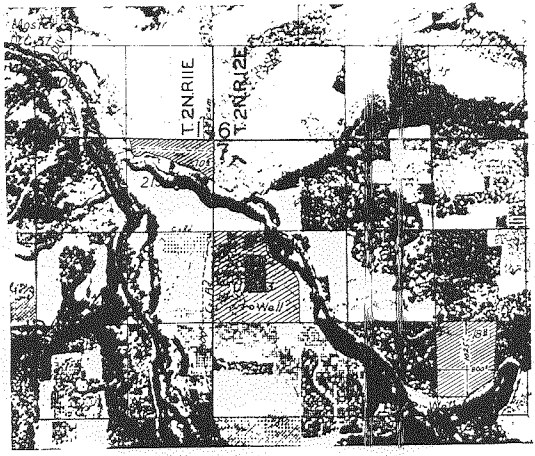

FINAL PROOF SURVEY

Surveyed 19 , by