
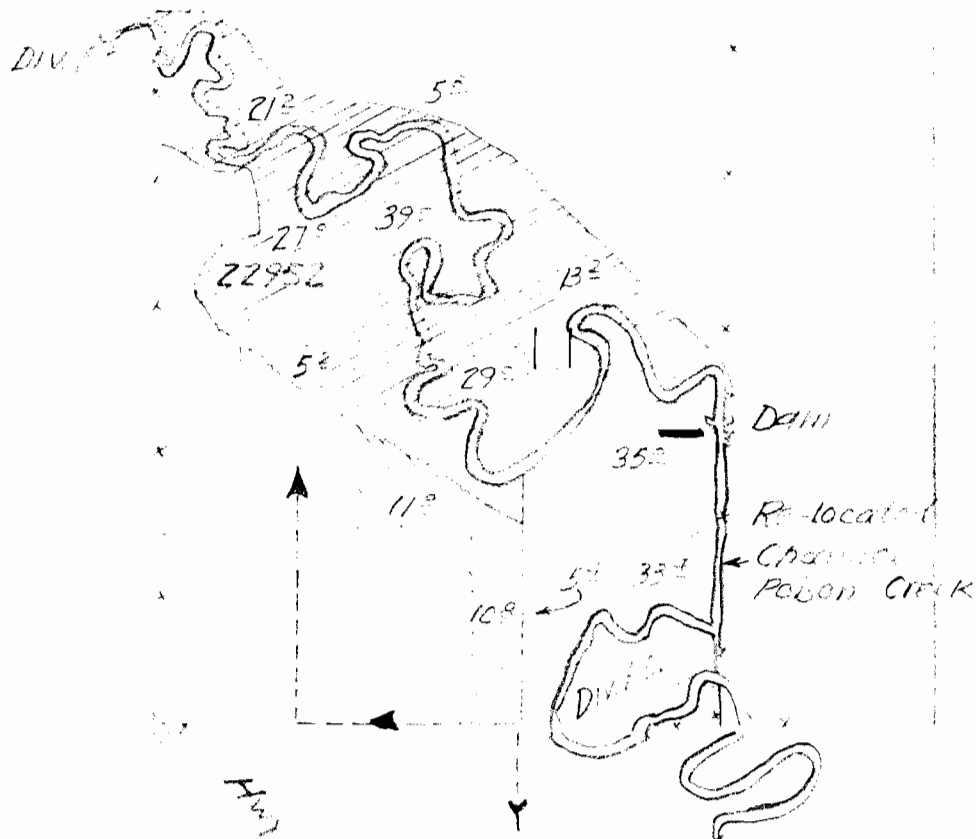


T23S. R31E. W.3M.

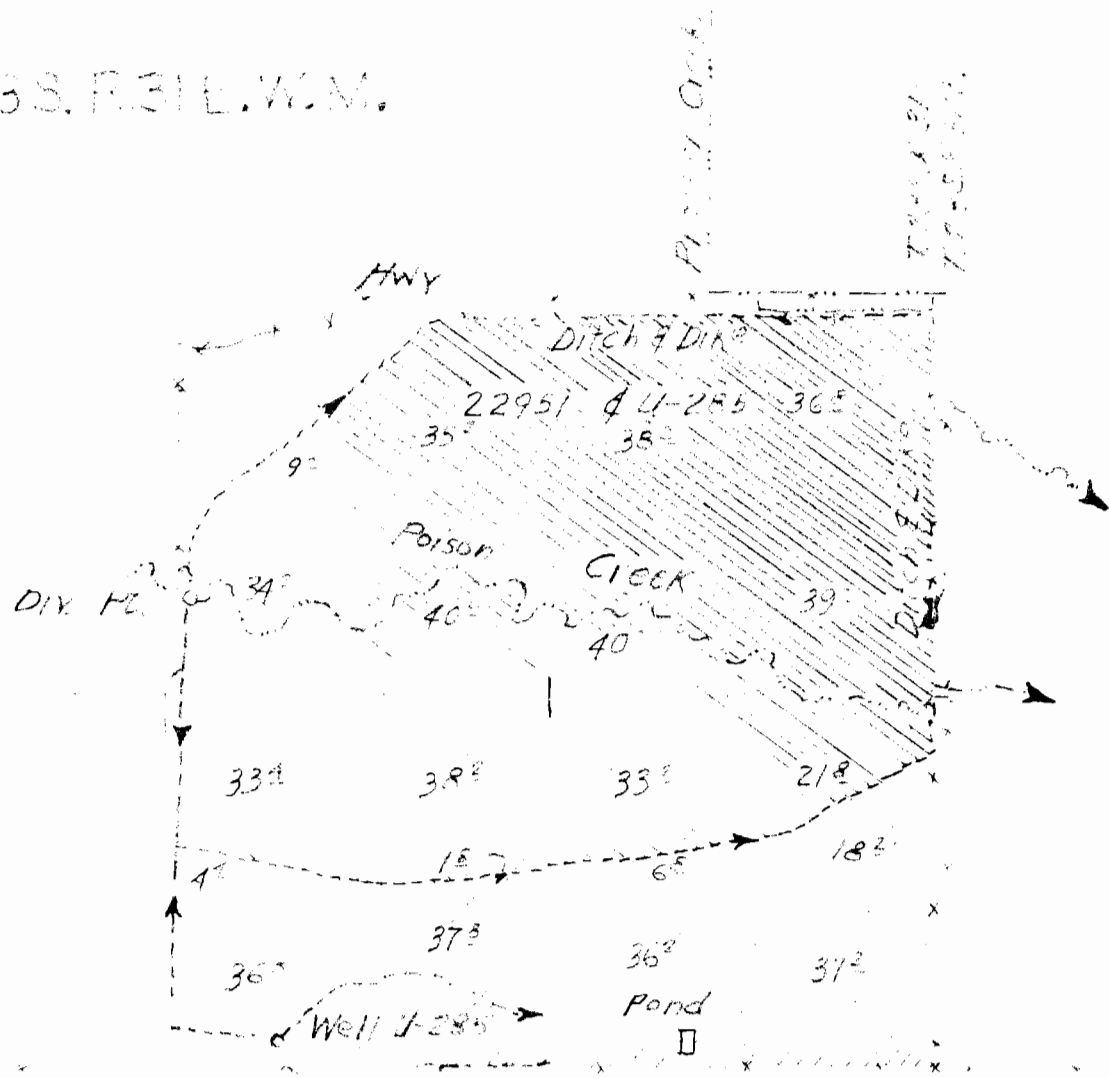

FINAL PROOF SURVEY

UNDER

APPLICATION NO.


22951



IN NAME OF
RILEY & SEWELL

T23S. R31E. W.M.

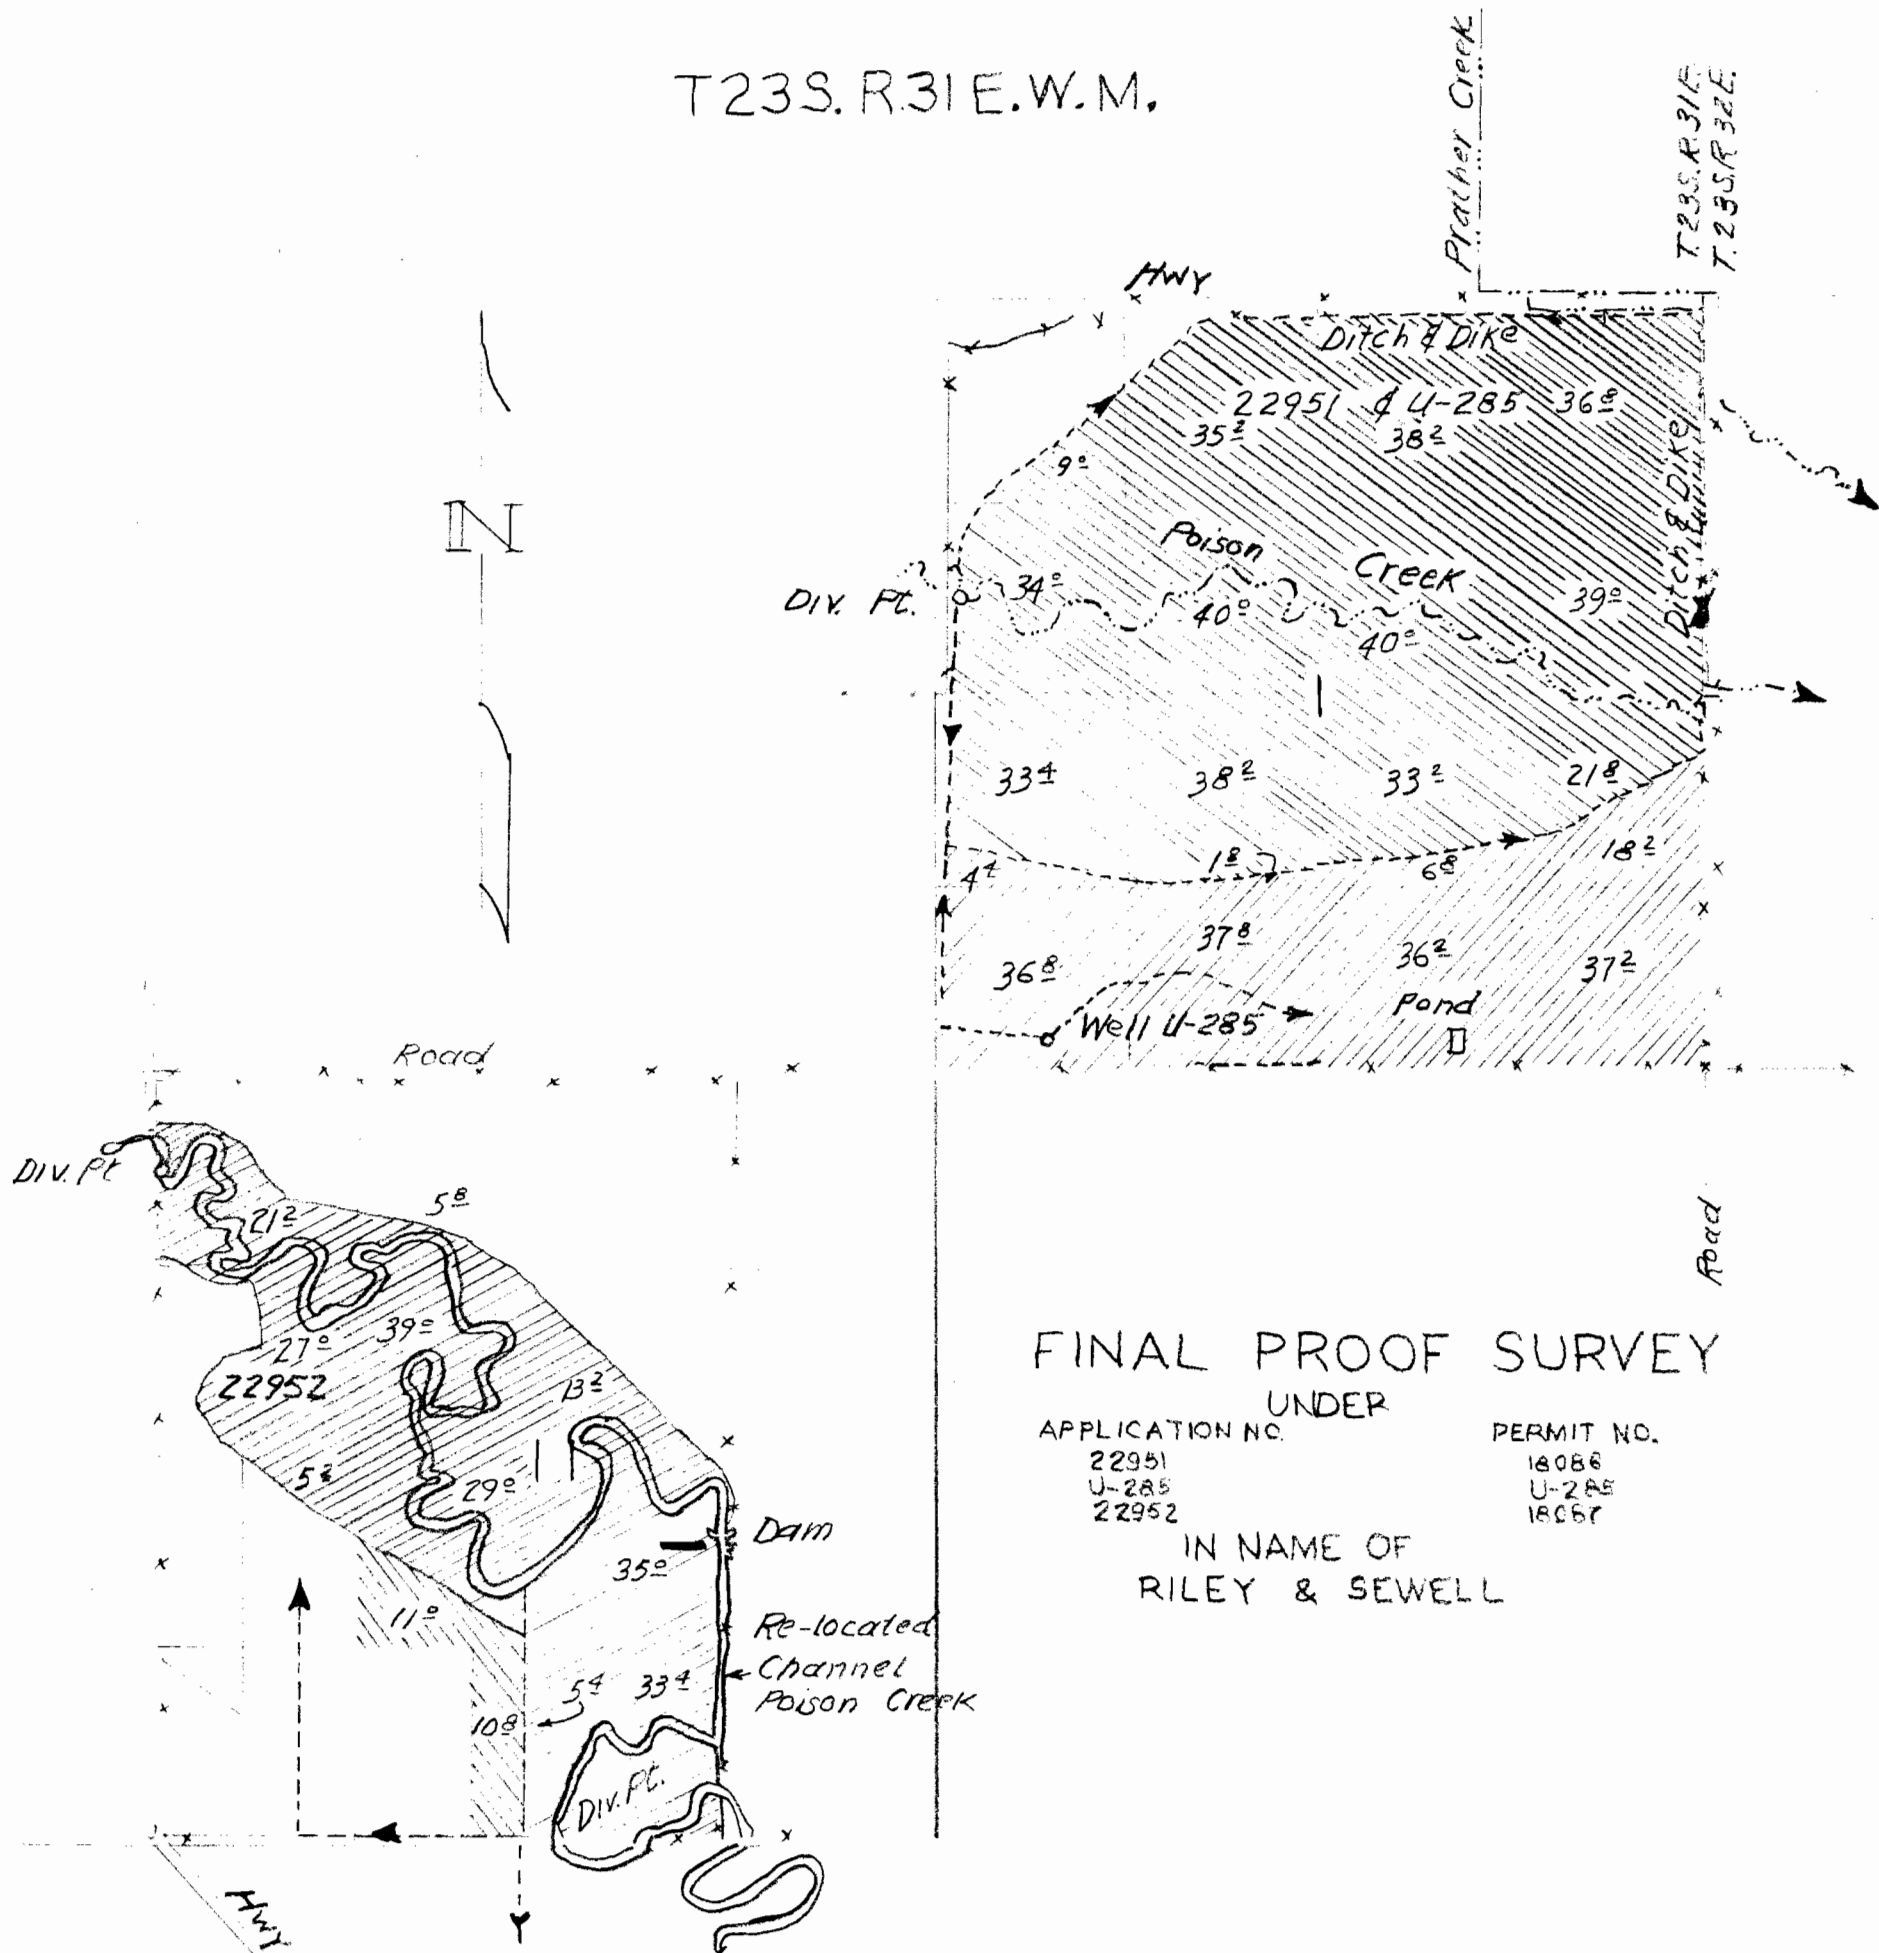

FINAL PROOF SURVEY

UNDER

APPLICATION NO.

22951
U-285
22952

PERMIT NO.

18086
U-285
18087


IN NAME OF
RILEY & SEWELL

copy of original final proof survey map

T23S. R.31E. W.M.

Prather Creek

T.23S. R.31E.
T.23S. R.32E.

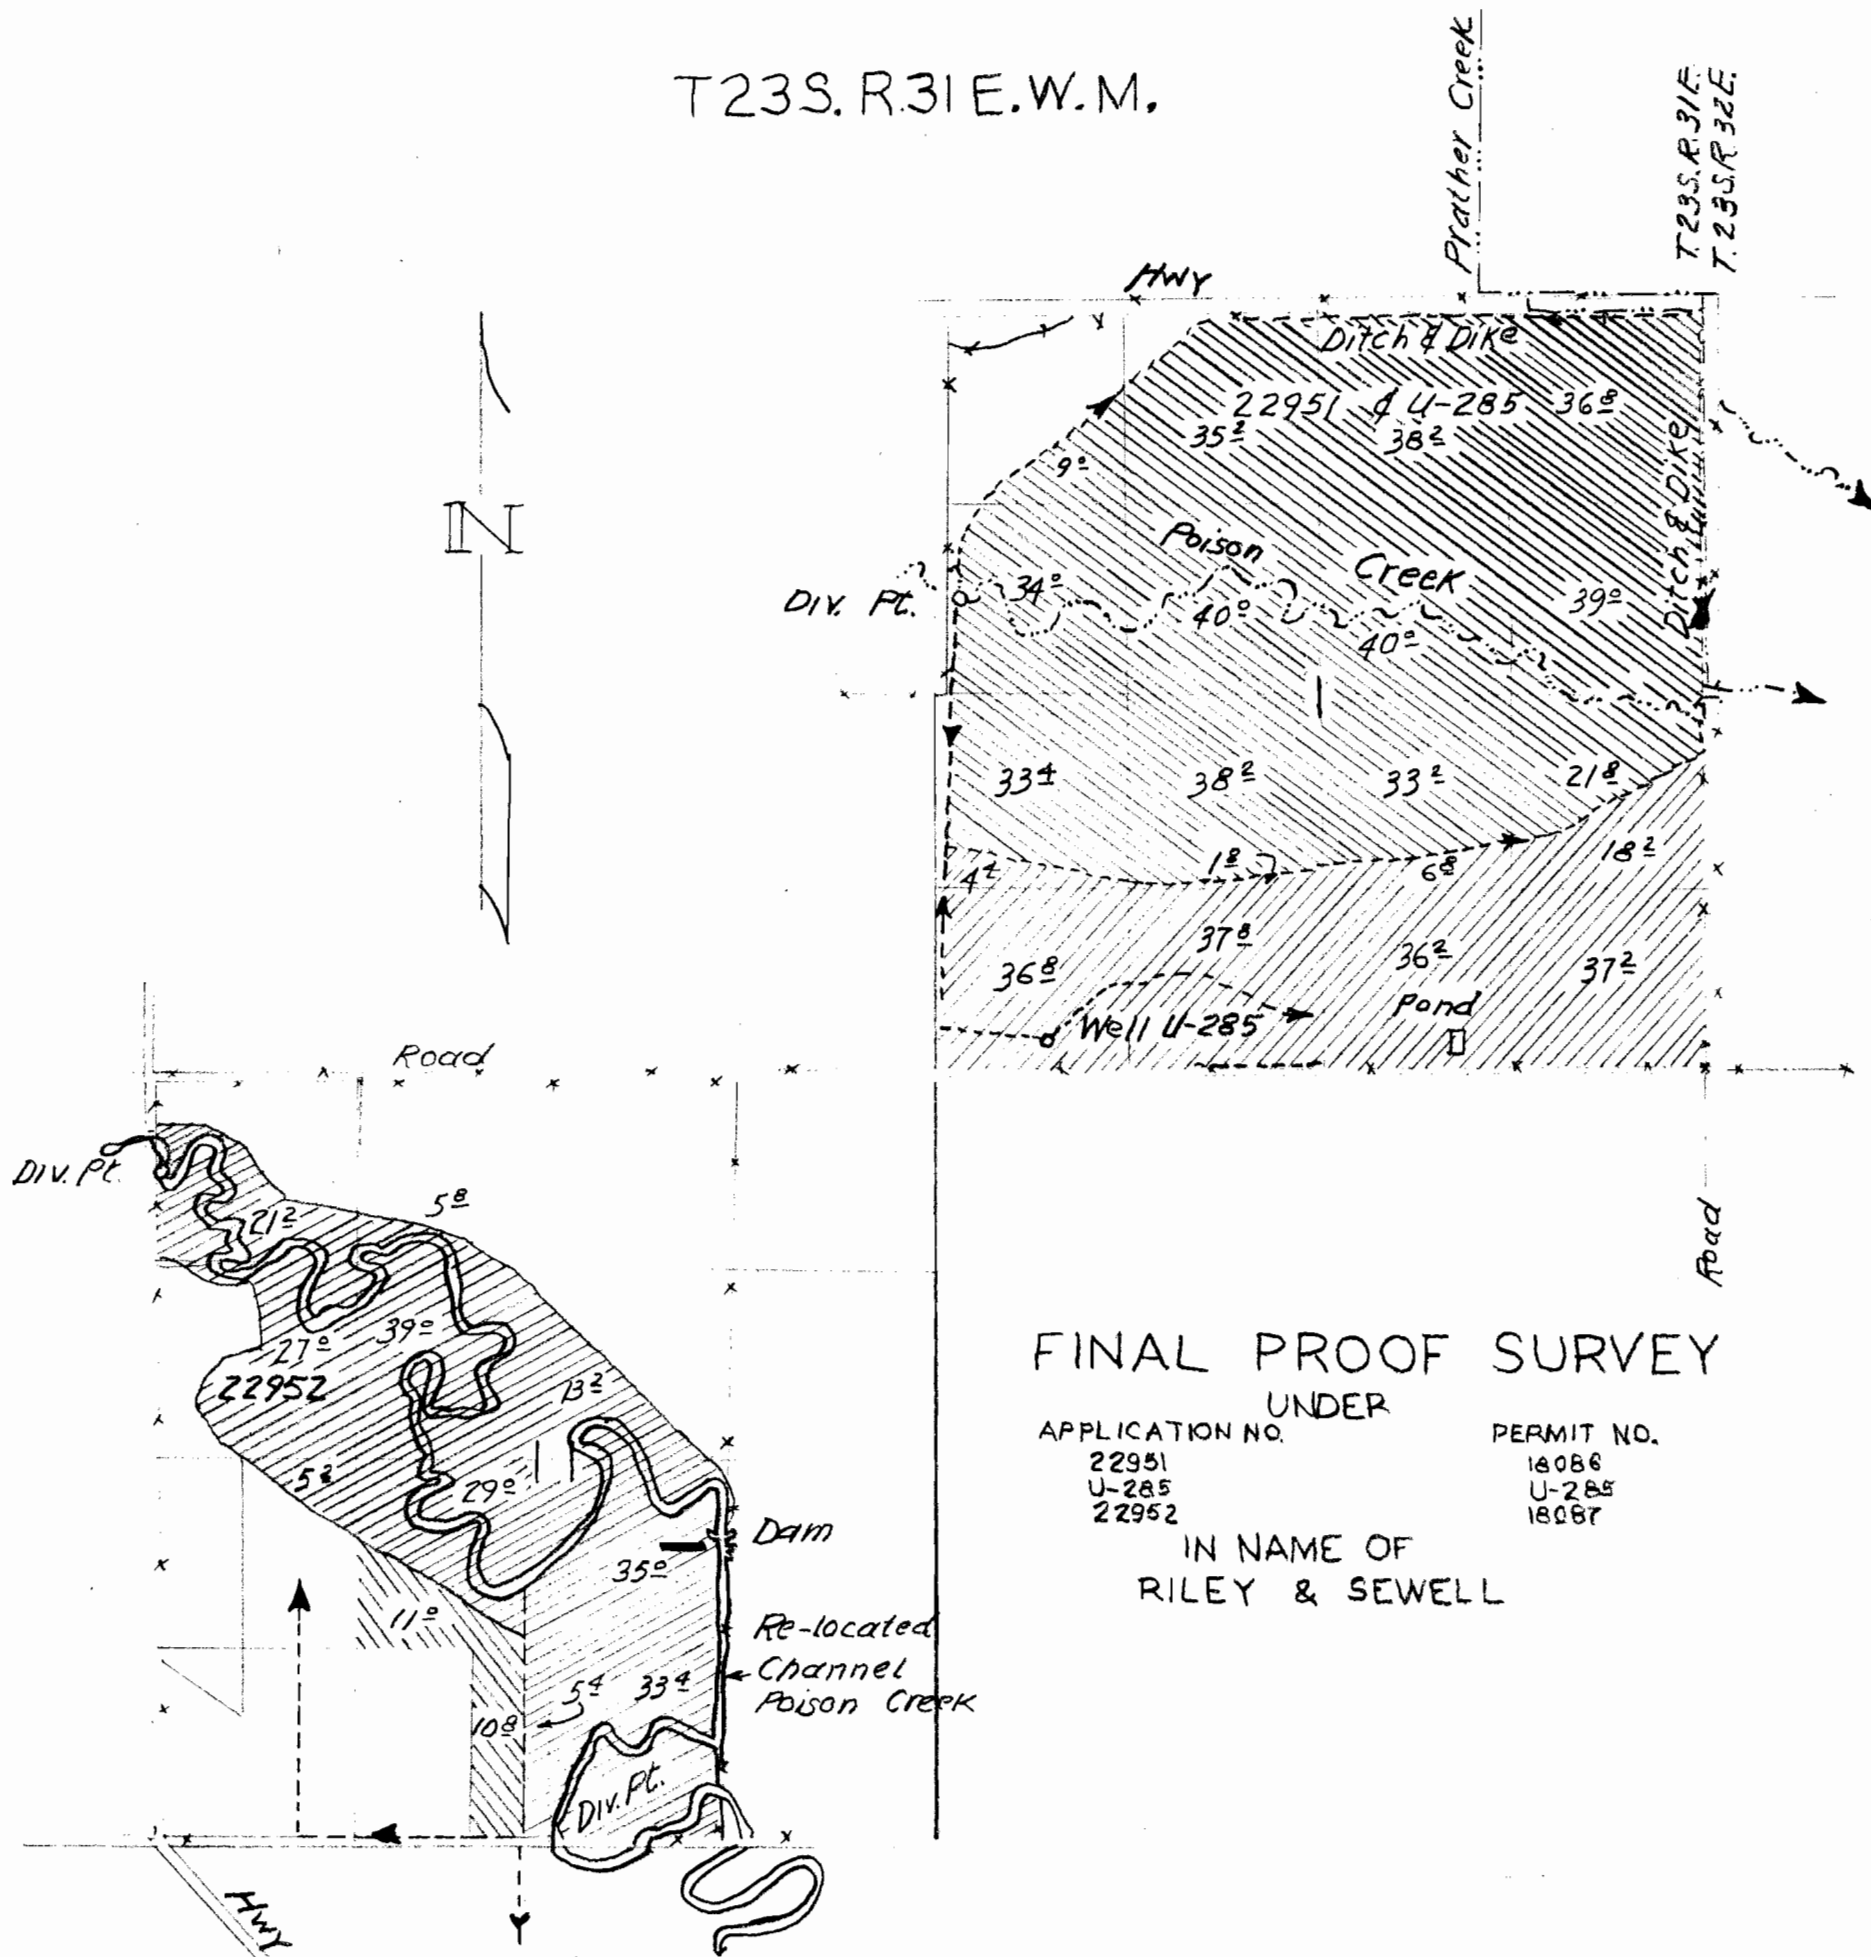

FINAL PROOF SURVEY

UNDER

APPLICATION NO.

22951
U-285
22952

PERMIT NO.

18086
U-285
18087




IN NAME OF
RILEY & SEWELL

Copy of original final proof survey map

T23S. R.31E. W.M.

Prather Creek

T.23S. R.31E.
T.23S. R.32E.

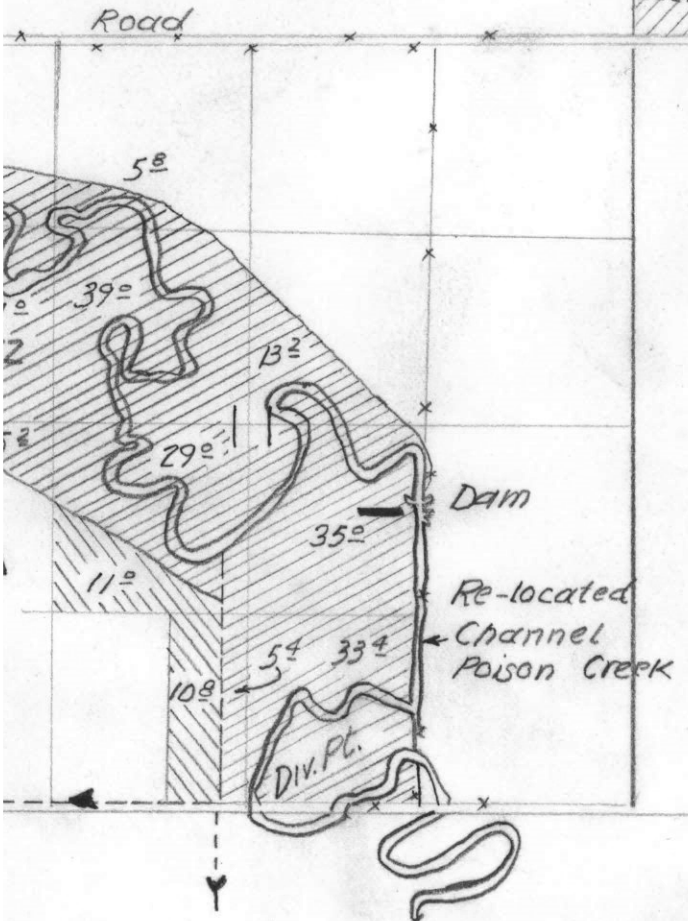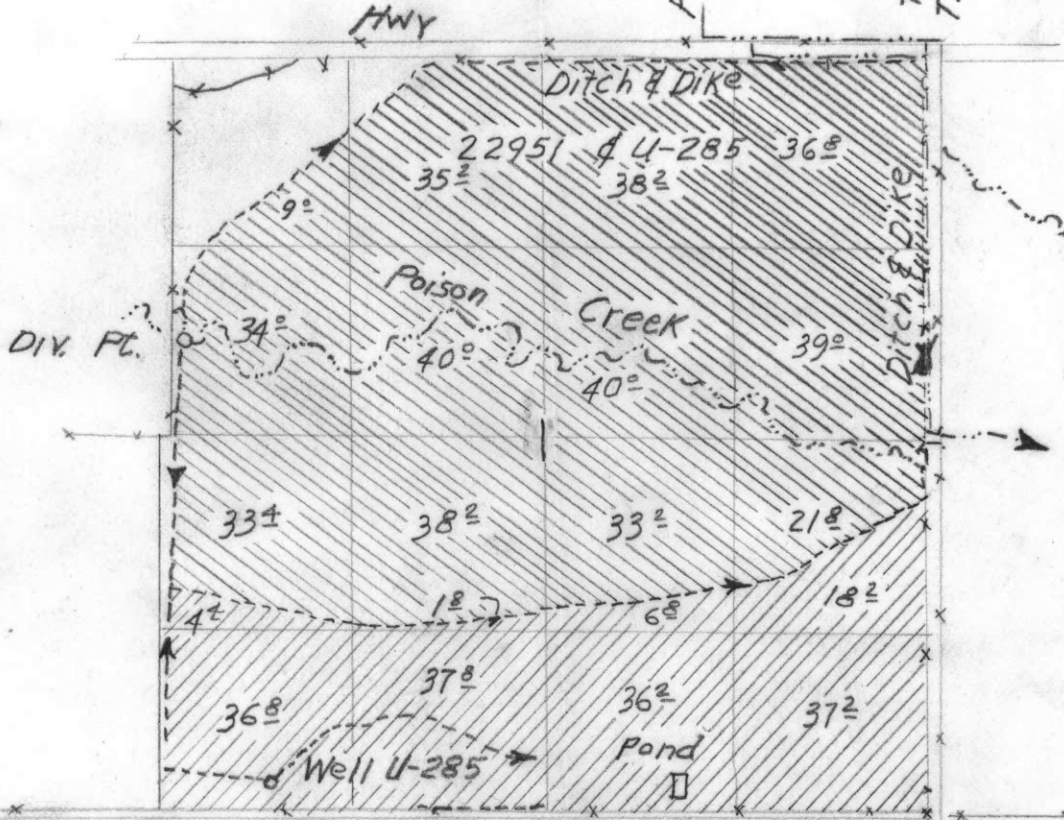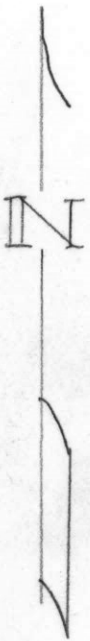

FINAL PROOF SURVEY

UNDER

APPLICATION NO.
 22951
 U-285
 22952

PERMIT NO.
 18086
 U-285
 18087

IN NAME OF
 RILEY & SEWELL

original final proof survey map