


T23S. R.31E. W.M.

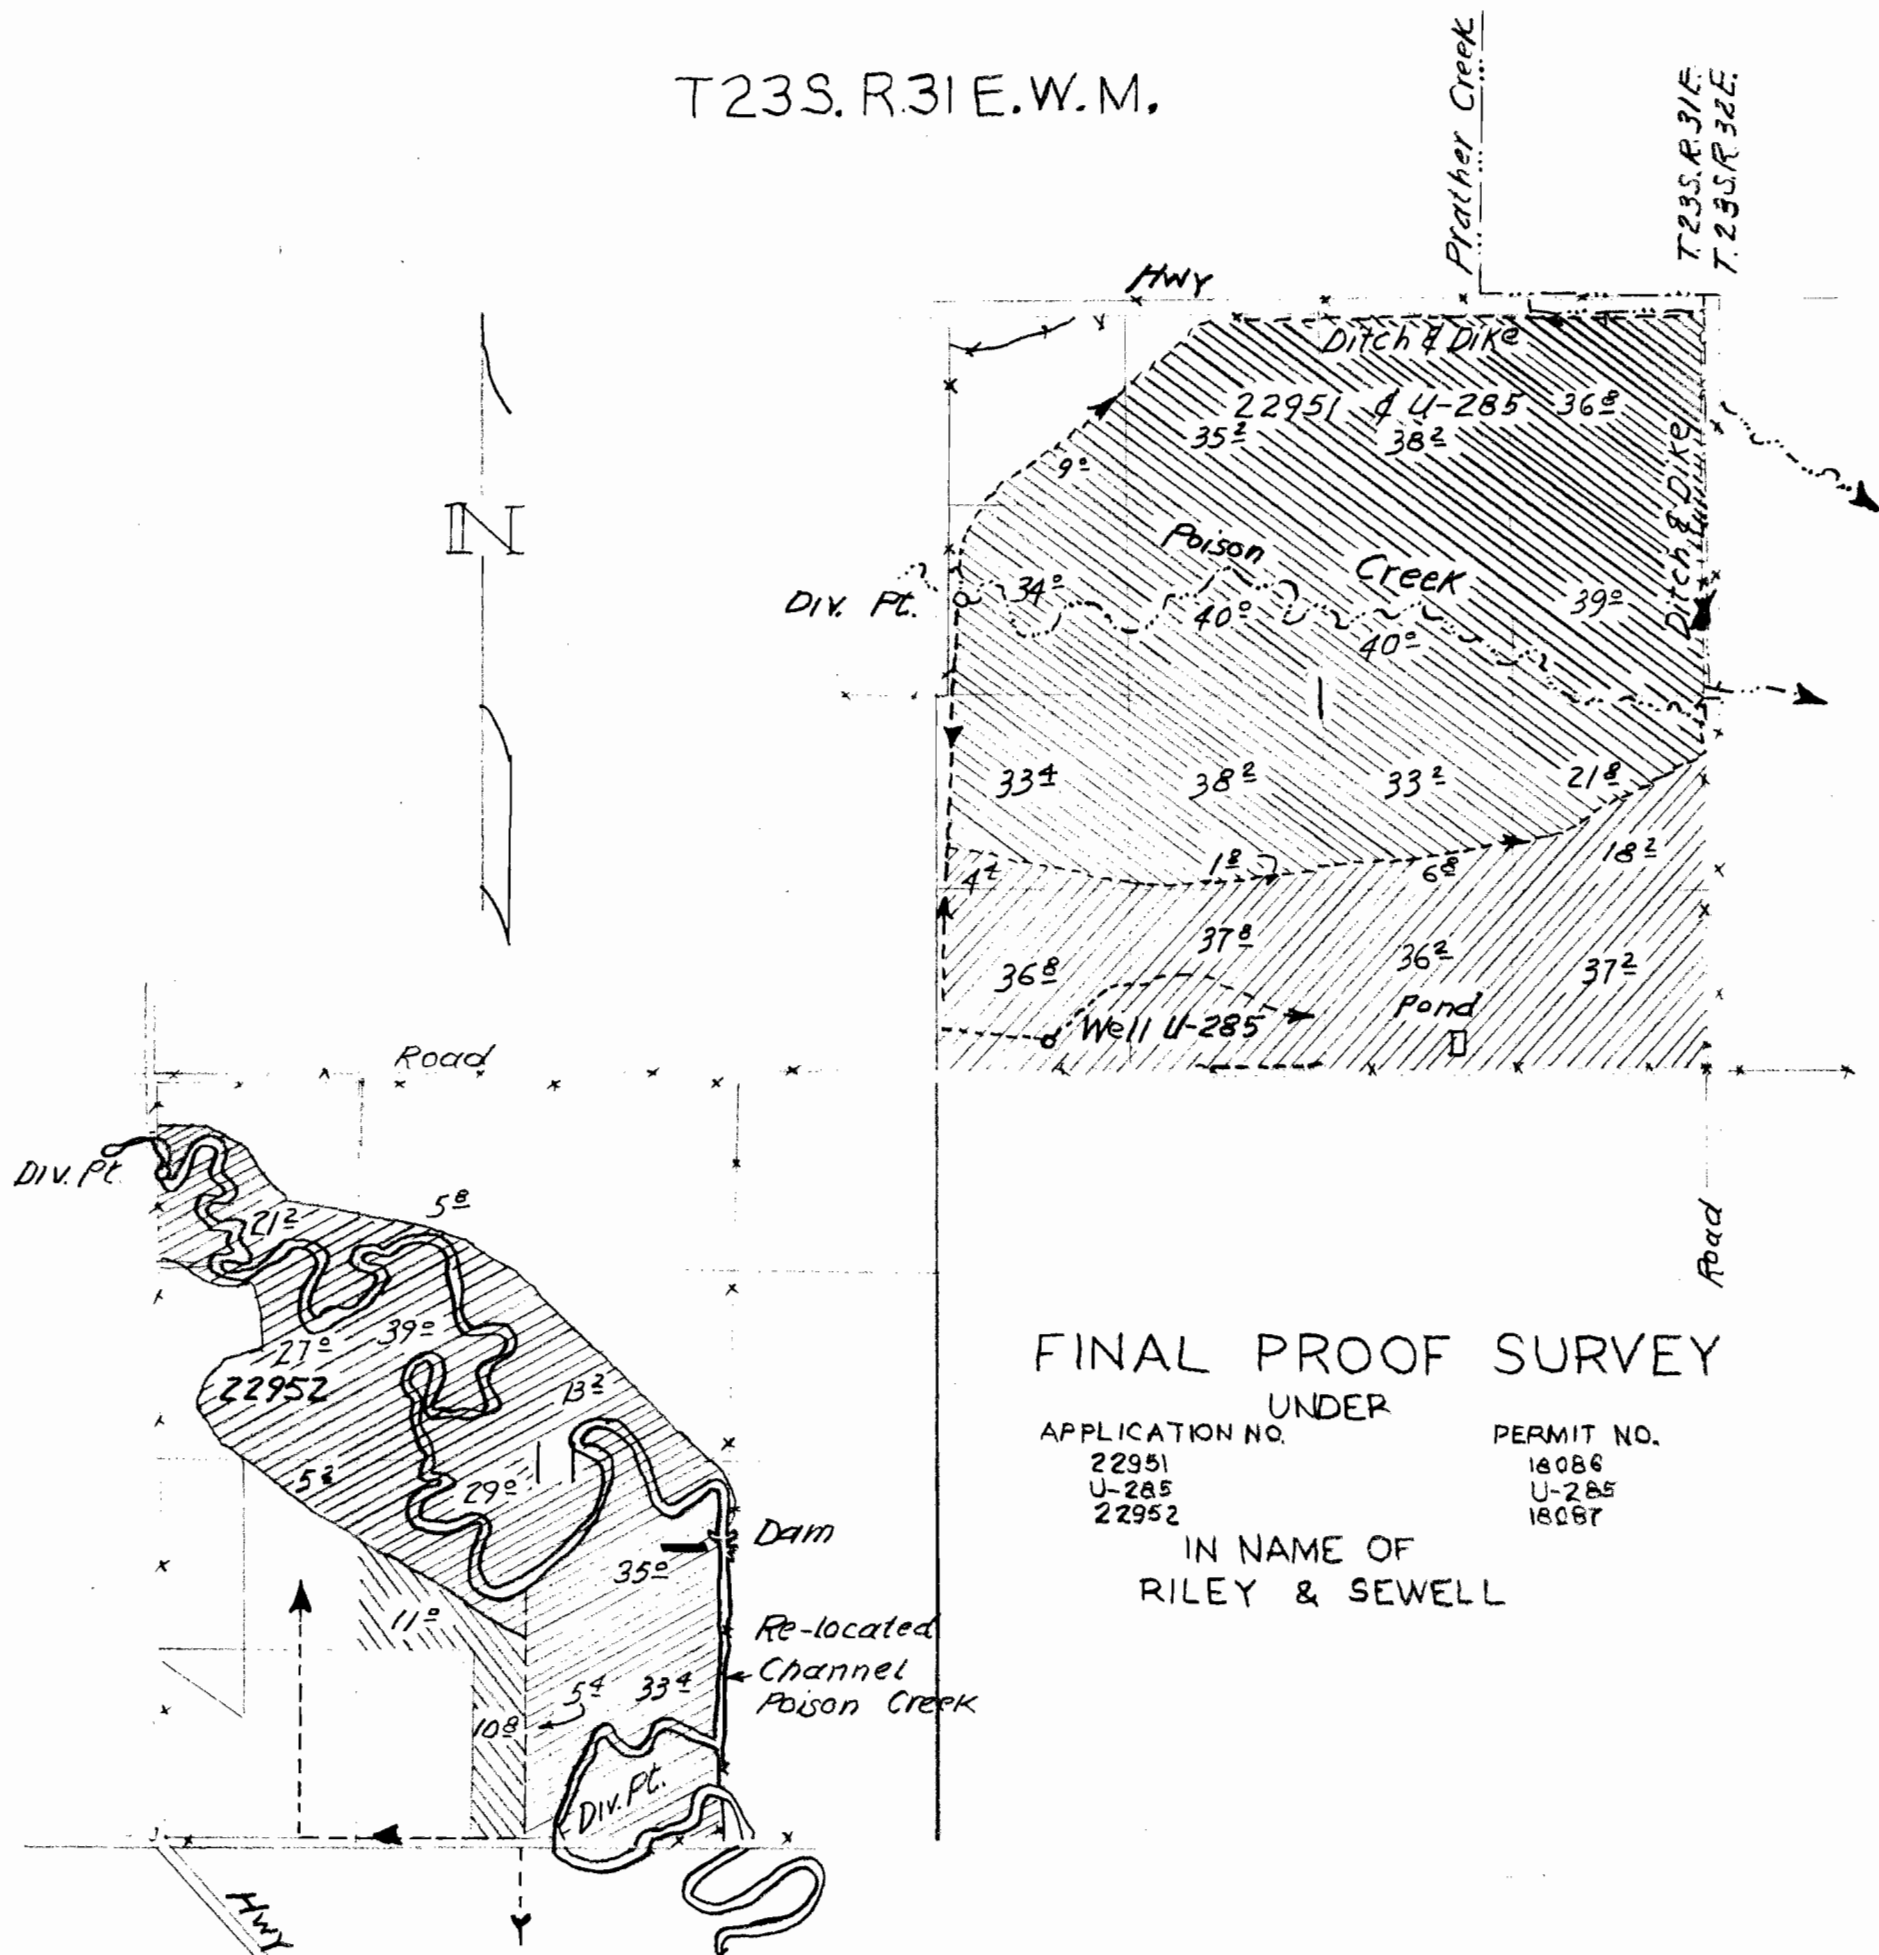

copy of original final proof survey map