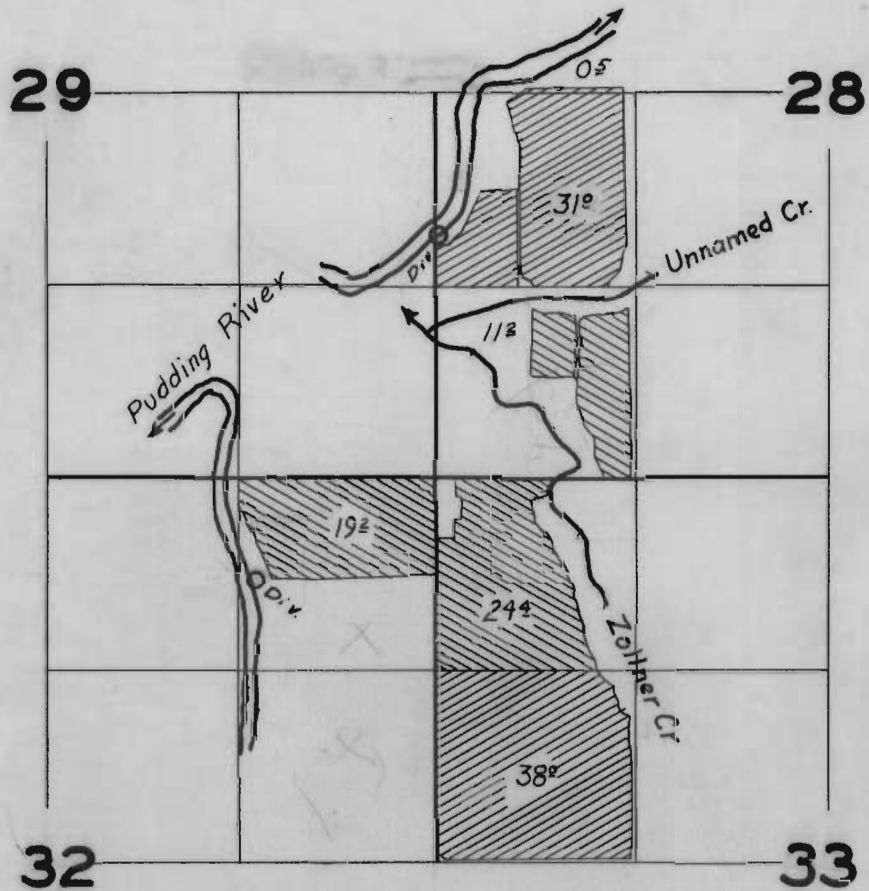

 


T.5S.R.1W.WM



Appl. No. 25021 
 Appl. No. 20402 

FINAL PROOF SURVEY

UNDER

Application No. 25021 Permit No. 19713 19713
20402 15908 15908

IN NAME OF

Joe Obersimer

Surveyed May 26 1954, by M. L. Coffman