


T. 16 S., R. 2 W., W.M.

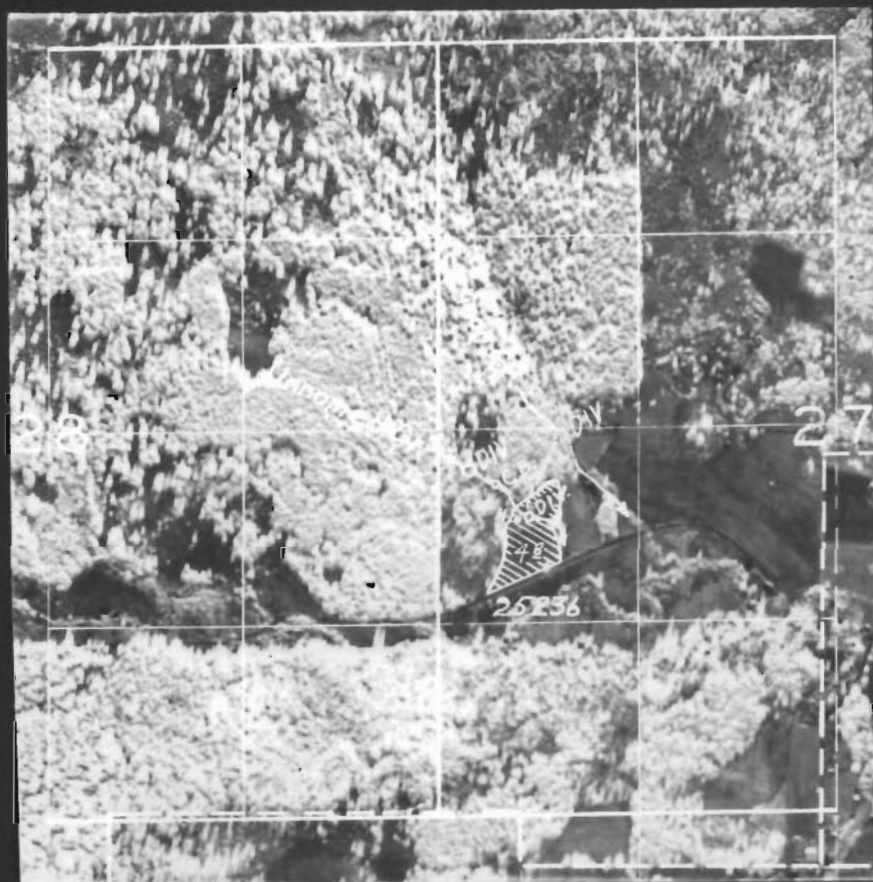

FINAL PROOF SURVEY
UNDER

Application No. 25236..... Permit No. 12828.....
IN NAME OF

..... F. E. Diehnel

Surveyed April 21 19 54, by T. Jones.....