


# T.21S.R.1W.WM

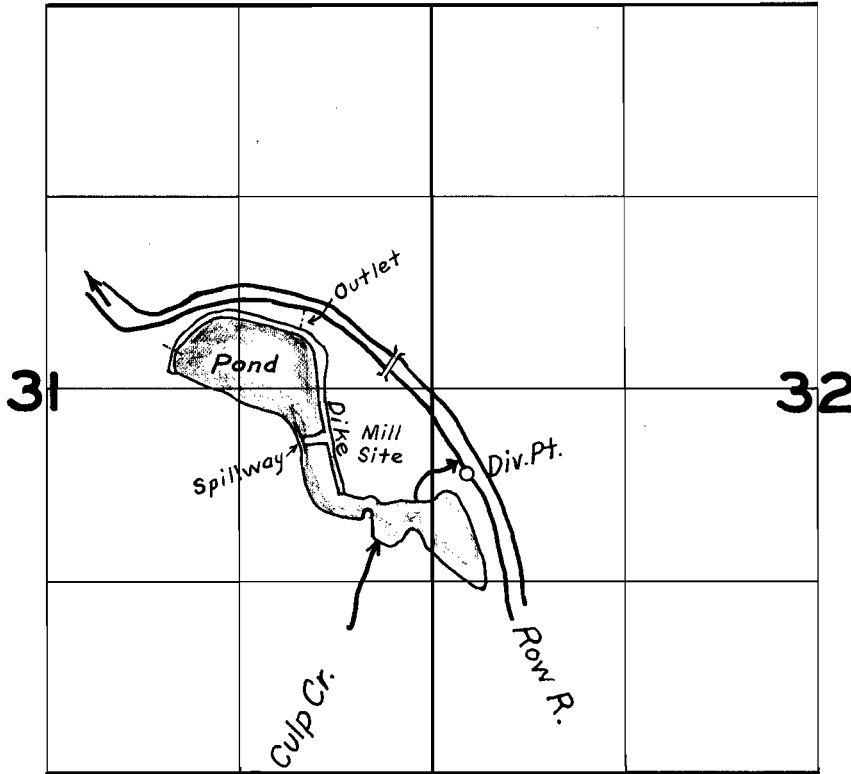

## FINAL PROOF SURVEY

UNDER

R-25502 1-1204  
1945 20487  
Application No. 25570 Permit No. 20514

IN NAME OF

Bohemian Lumber Co., Inc.

Surveyed May 4, 1954, by T. Jones