


Apparent error in **T.27 S. R.5W.W.M.**

South Section line as drafted from
Photo DC-343

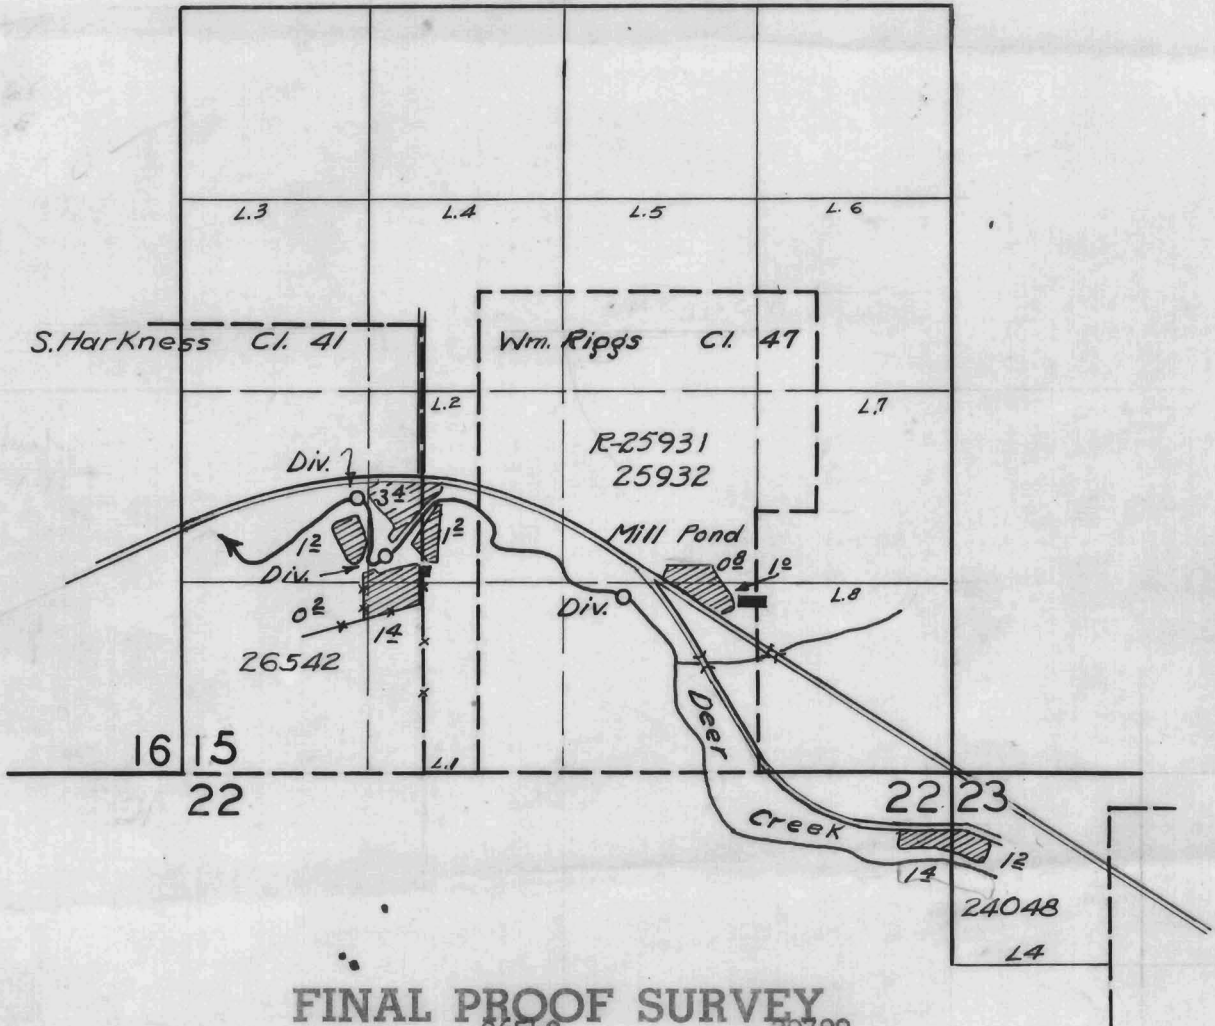

FINAL PROOF SURVEY

26542 20799
R-25931 R-1168
25932 20336

Application No. 24048 Permit No. 19077

L. V. Beckley
Perkins Veneer Company
Perkins Veneer Company
R. B. White and Rose White

Surveyed July 20, 1954, by H. L. Coffman

DC-3-43
Pantograph