


T.11 S.R.3 W WM

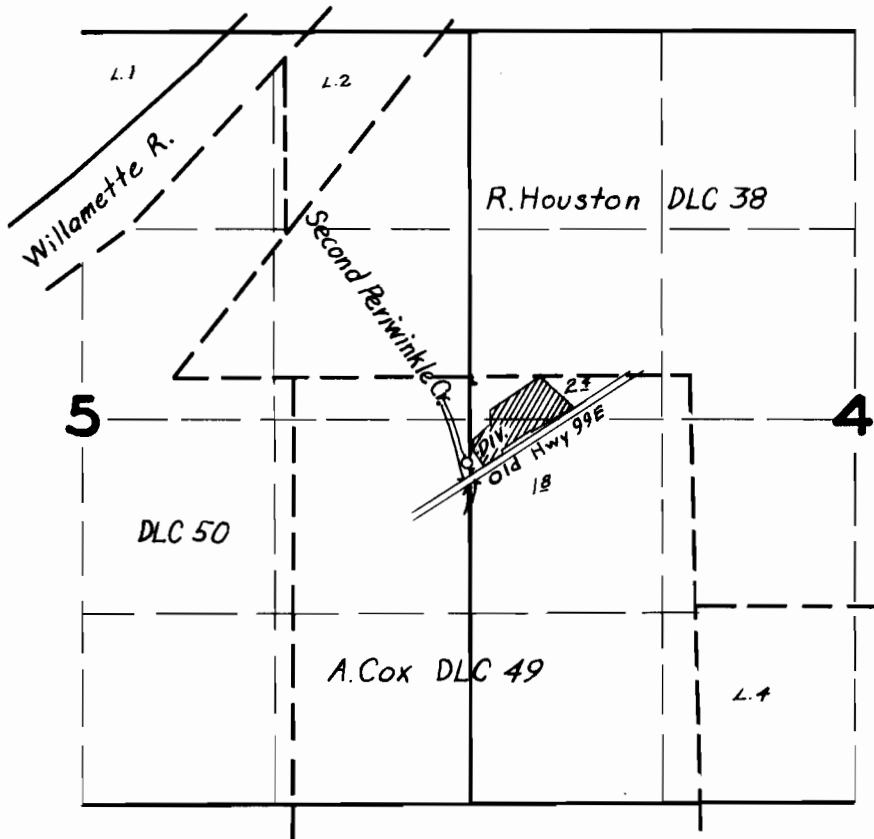

FINAL PROOF SURVEY

UNDER

Application No. 15385 Permit No. 11277

IN NAME OF

St. Johns Lodge, A. F. & A.M. No. 17

Surveyed Aug. 16 1954, by H. L. Coffman