


T.13S.R.1E.WM

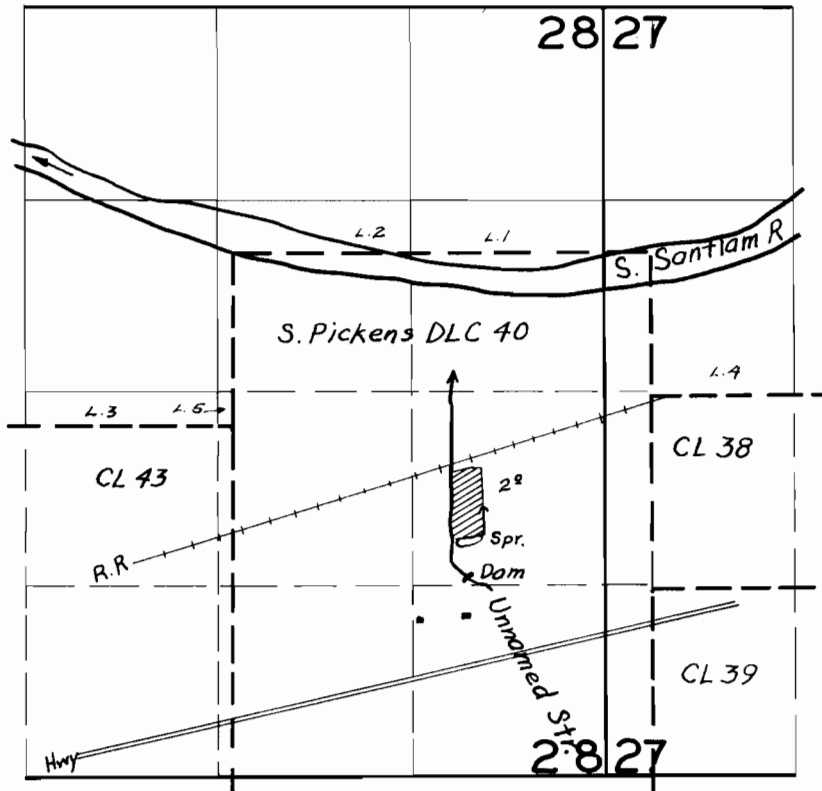

FINAL PROOF SURVEY

UNDER

Application No. 17528... Permit No. 13233...

IN NAME OF

G. Wodtli

Surveyed Aug. 19 1954, by H. L. Coffman

DEM-3H-156