


T.17S.R.8W.W.M.

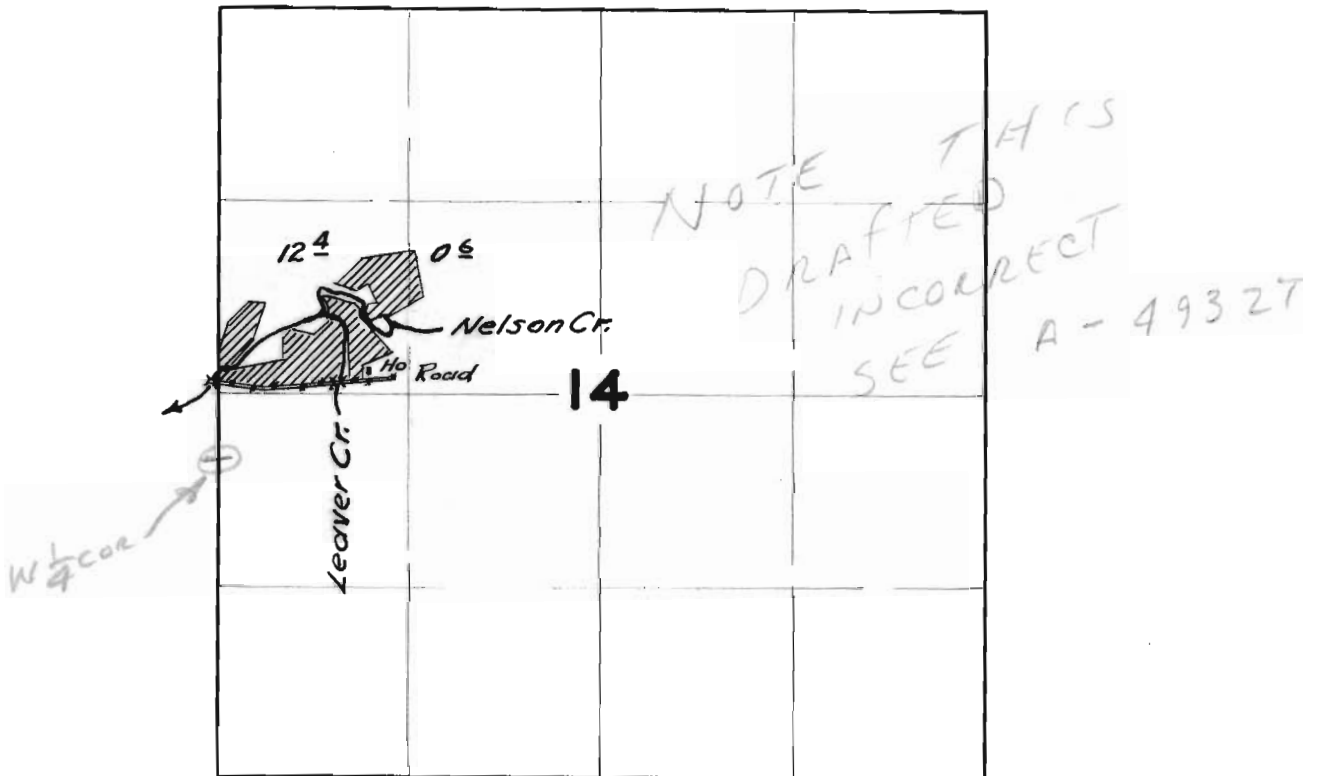

FINAL PROOF SURVEY
UNDER

Application No. 18375... Permit No. 14018...
IN NAME OF

JAMES & MYRTLE SCOTT

Surveyed MAY 8... 1950, by H.L. COFFMAN.