


T.6S. R6 & 7W.WM

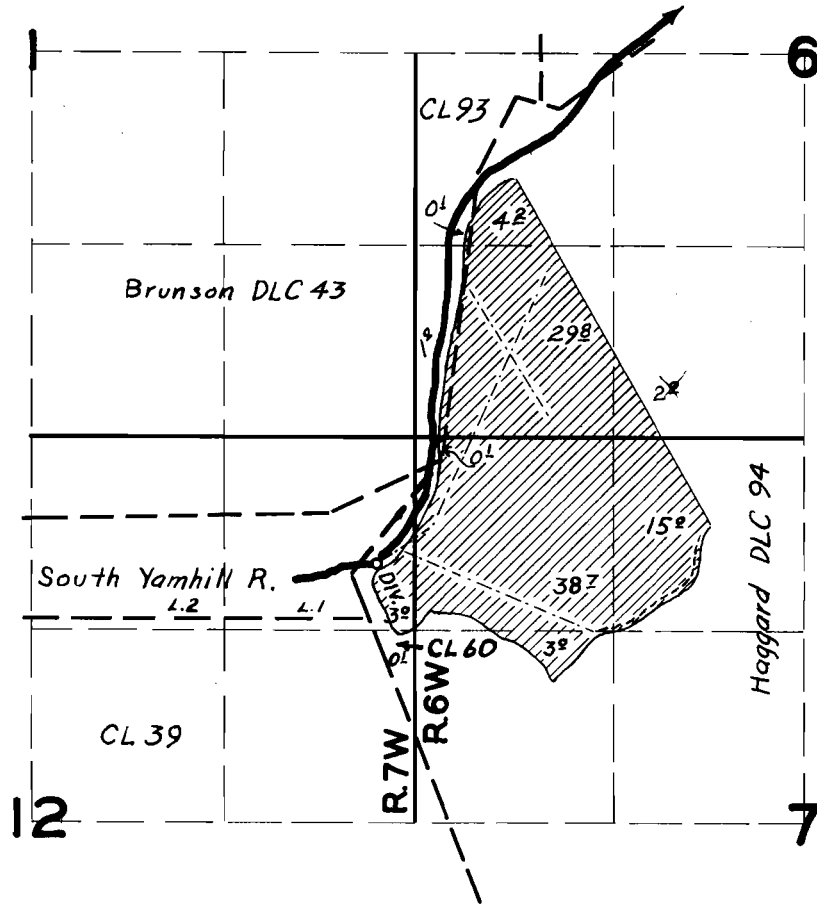

FINAL PROOF SURVEY

UNDER

Application No. 17629 Permit No. 1-313

IN NAME OF

William Schulz

Surveyed July 13, 1954, by T. Jones