


Per 17135
20996

T13S.R.28E.W.M.

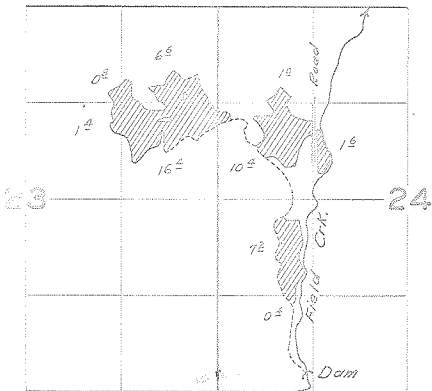

FINAL PROOF SURVEY

UNDER

Application No. 21781..... Permit No. 17135....

IN NAME OF

.....George R. Barry.....

Surveyed Aug. 30, 1951., by R. L. Coffey

16-15
Pantograph