


T. 30 S. R. 5 W. W.M.

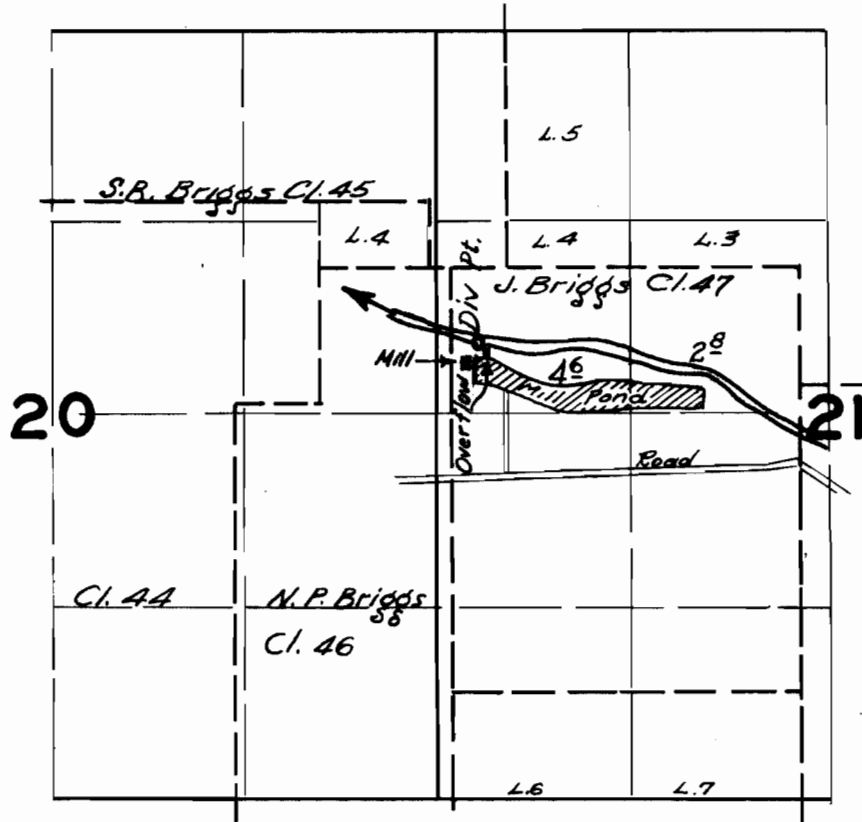

FINAL PROOF SURVEY

UNDER

Application No. 21965 Permit No. 17348

IN NAME OF

Keystone Lumber Co.

Surveyed July 23 19 54, by H. L. Coffman