




S.

Range 26 E.W.M..

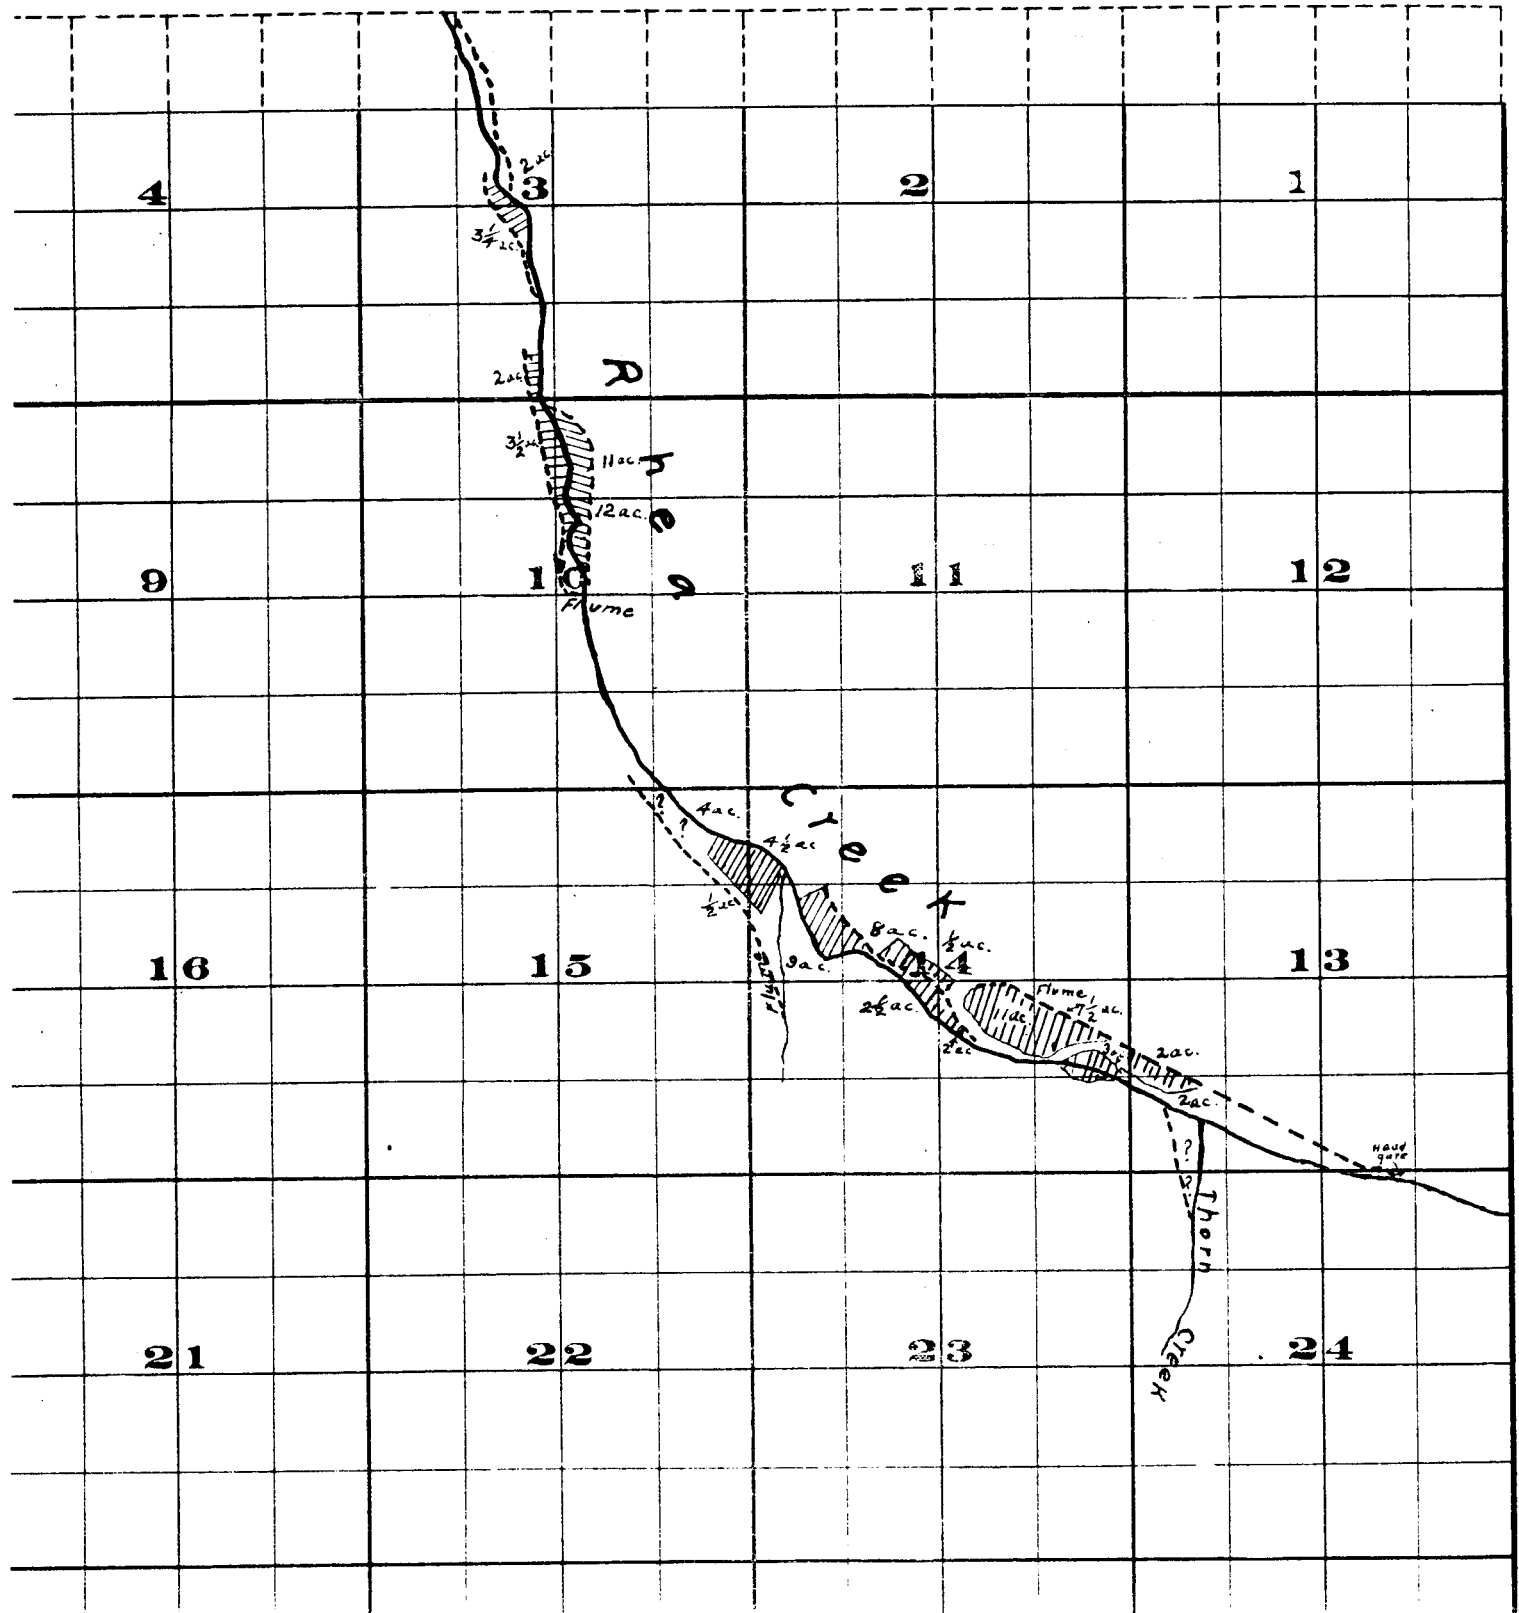

Township 4 S.

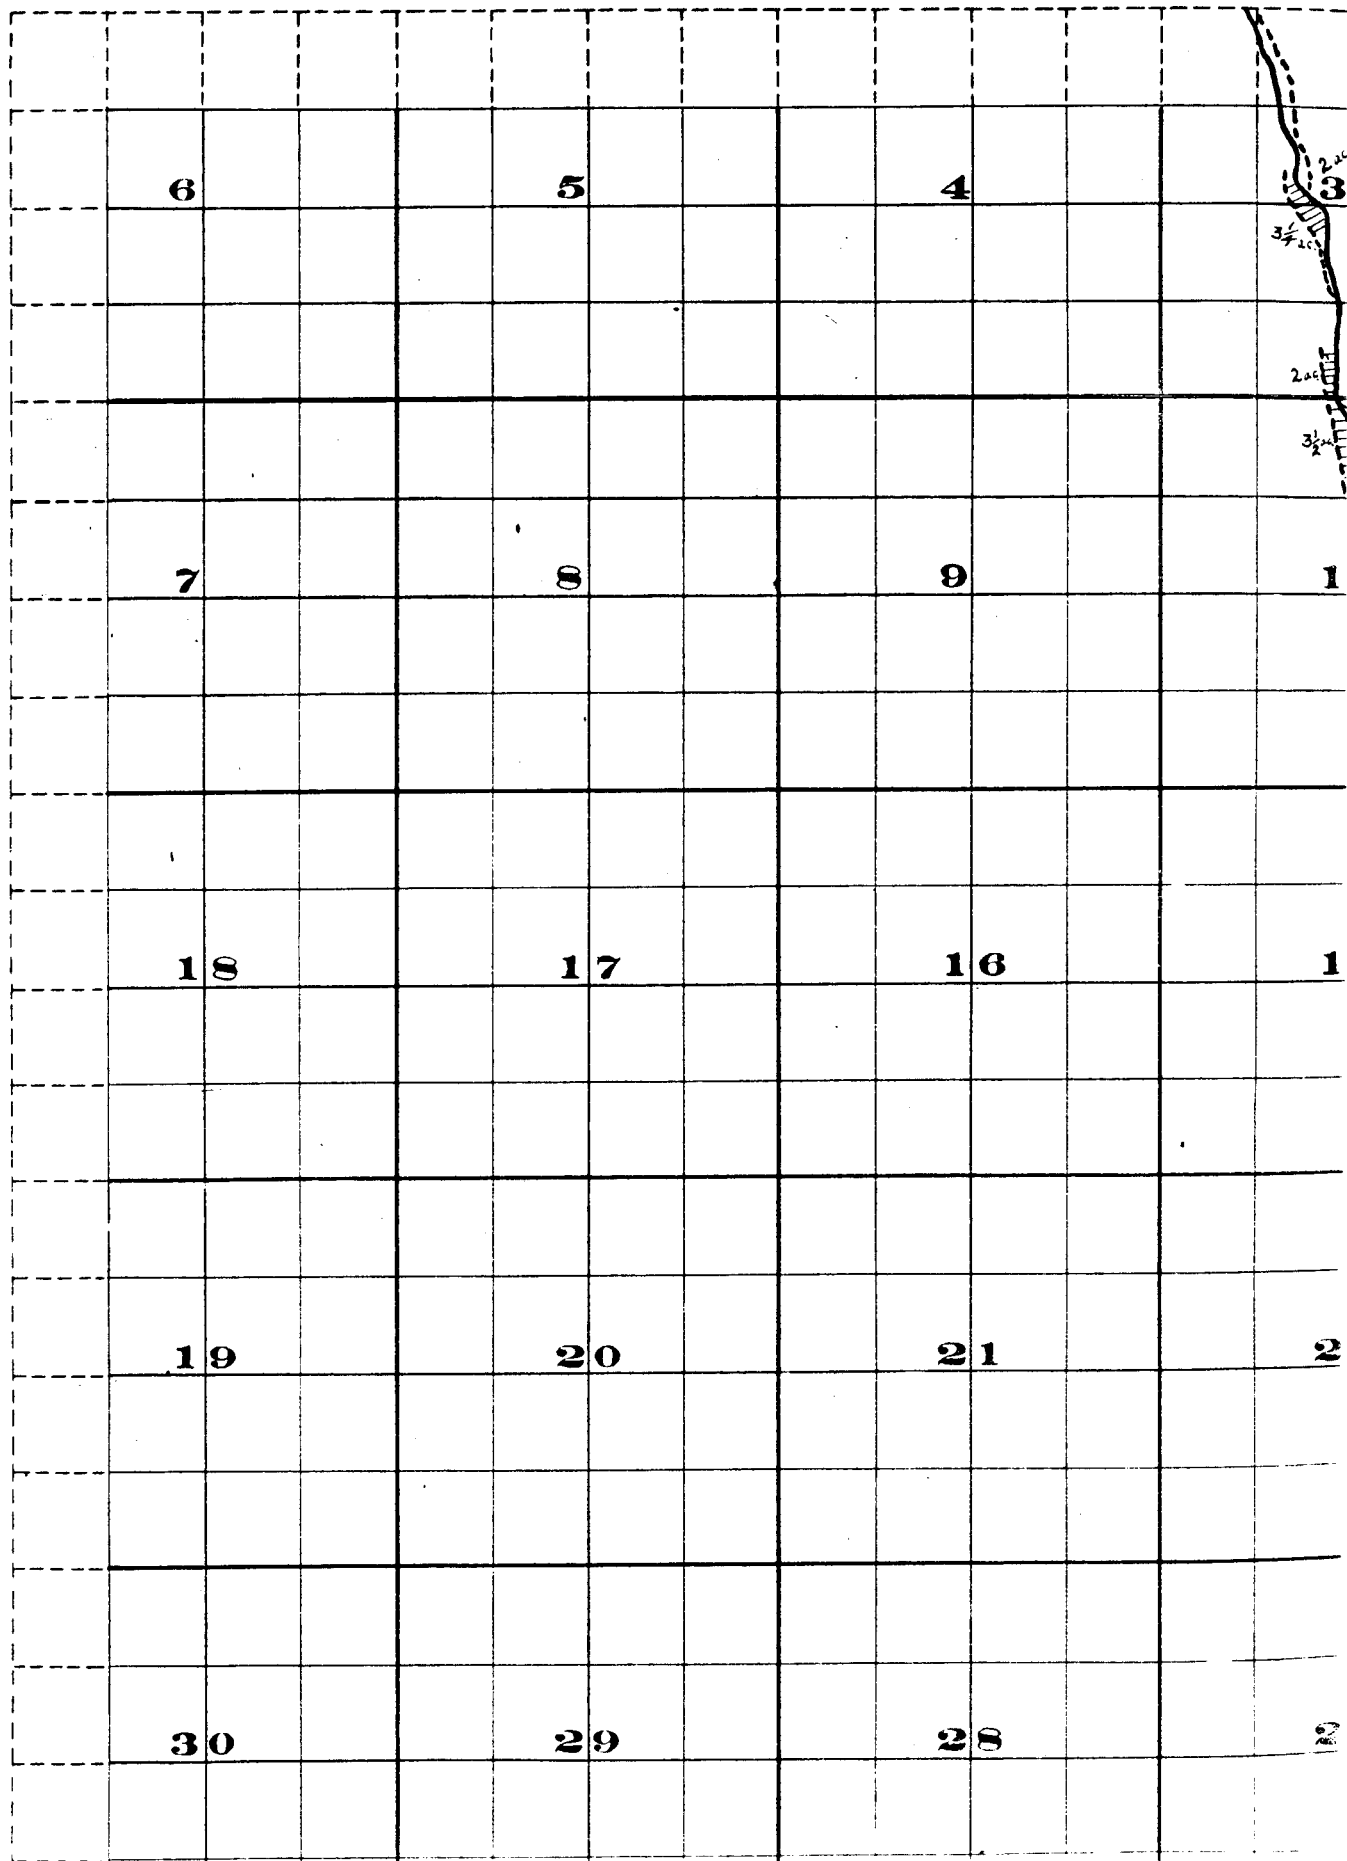


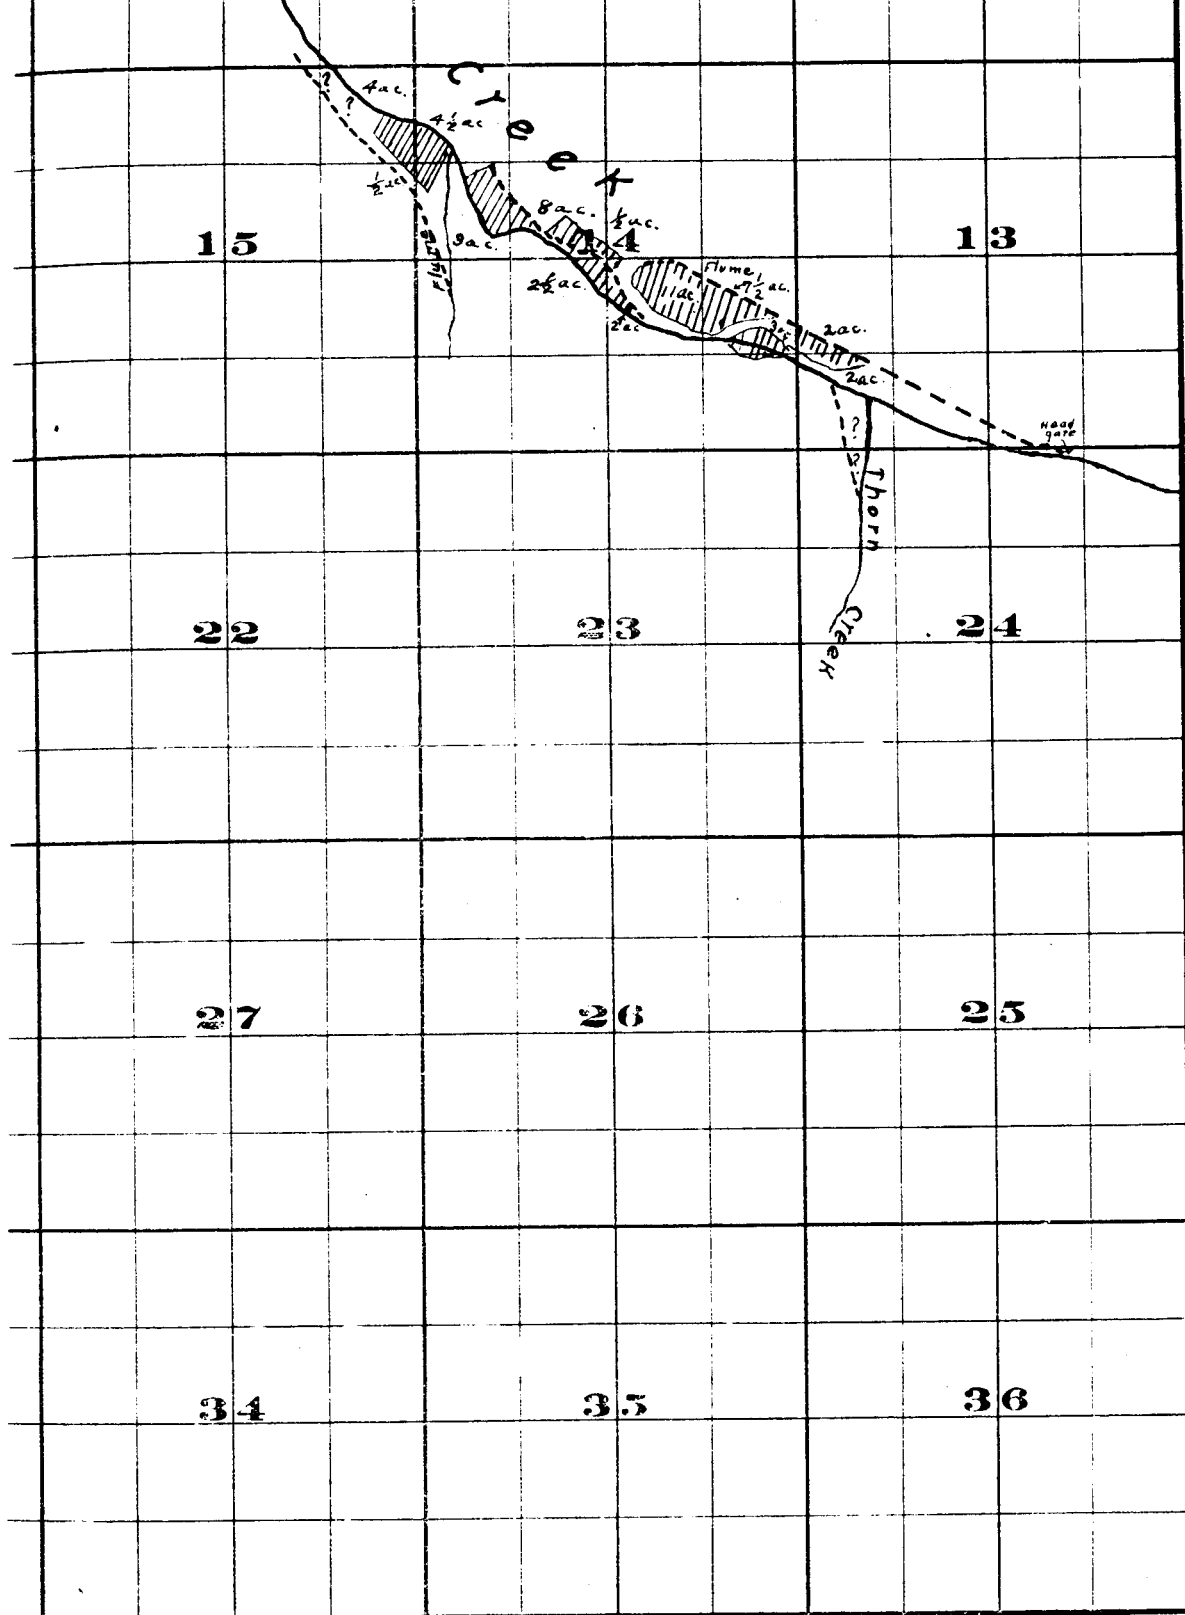

FROM OFFICE OF THE STATE ENGINEER, SALEM, OREGON

Willow Creek Adjudication

45.26

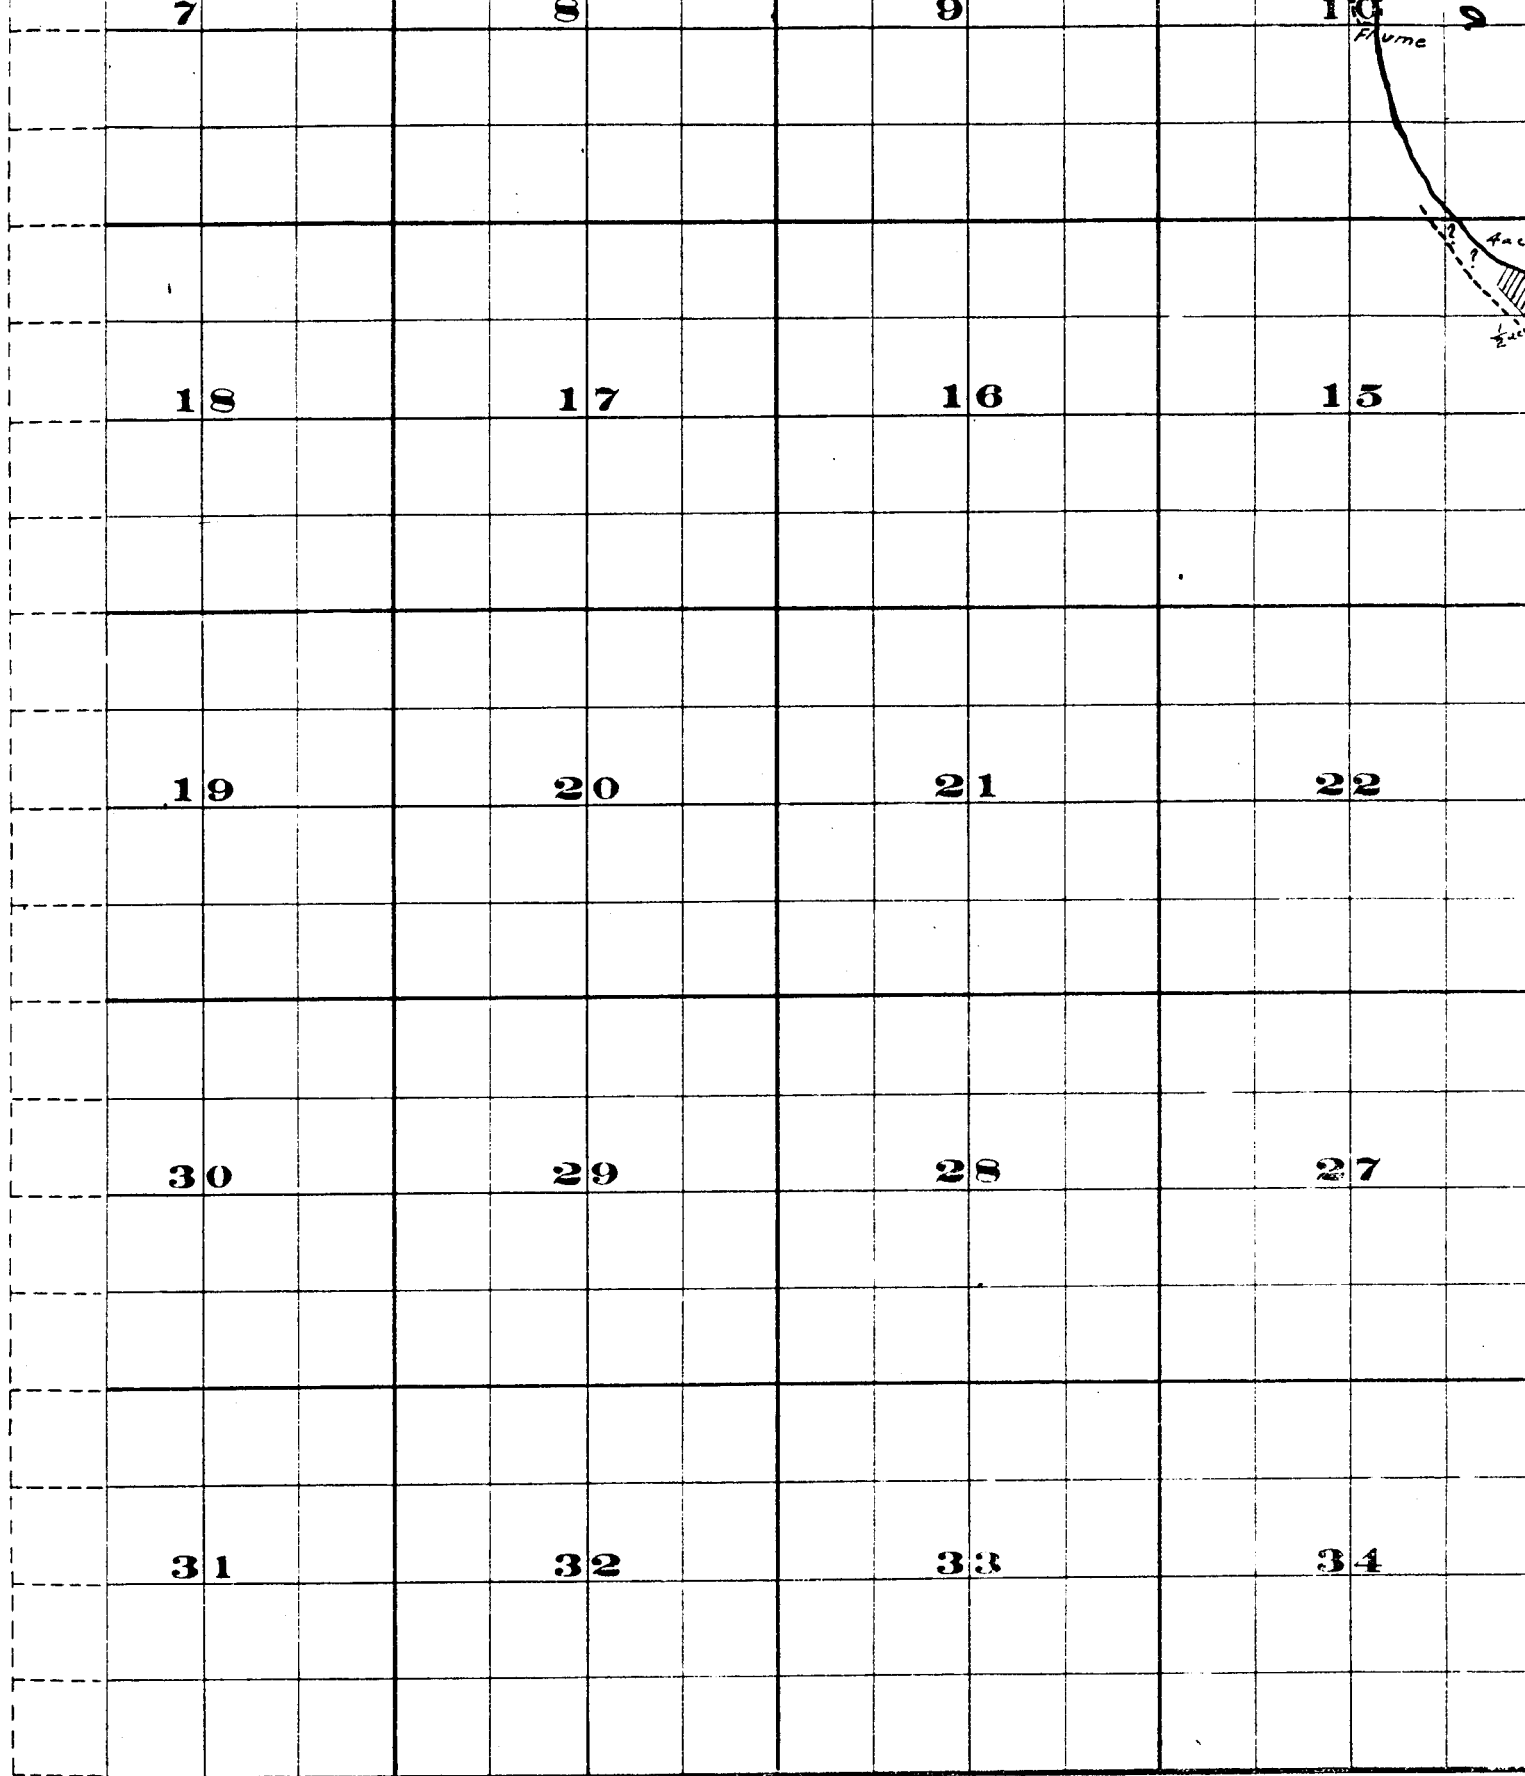

THE B. BRISTOL CO. PRINTERS & PUBLISHERS, CHICAGO, ILL.

Surveyed by H. K. Donnelly July 1909

John H. Lewis - State Engineer

Examined July 14, 1909.