


# T17S R2WWM

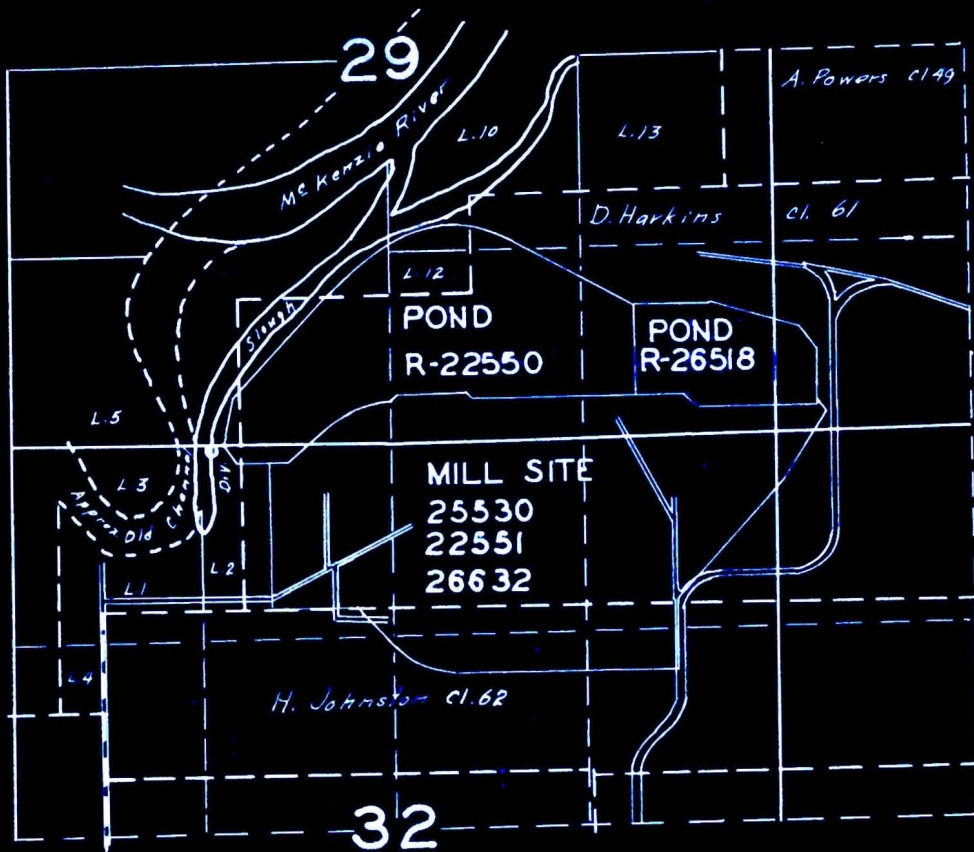

## FINAL PROOF SURVEY

22551  
R-22550  
R-26518  
25530  
26632

UNDER

17511  
R-861  
R-1265  
20053  
20864

Application No. \_\_\_\_\_ Permit No. \_\_\_\_\_  
IN NAME OF \_\_\_\_\_

Meyerhaeuser Timber Company \_\_\_\_\_

Surveyed April 22-1954, by T. Jones \_\_\_\_\_