


# T. 7S. R. 1E. WM

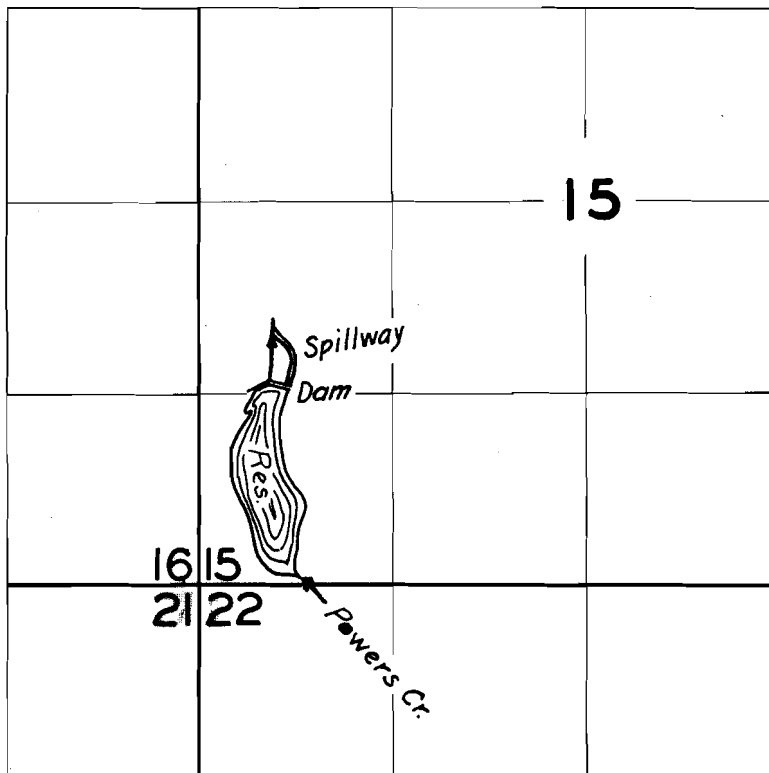

## FINAL PROOF SURVEY

UNDER

Application No. R-22646 22647 Permit No. R-948 10411

IN NAME OF

.....Willard L. Benson.....

Surveyed May 28 1954, by T. Jones.....