


SECTION

784  
31

TOWNSHIP 17, RANGE 43 E, W. M.

North

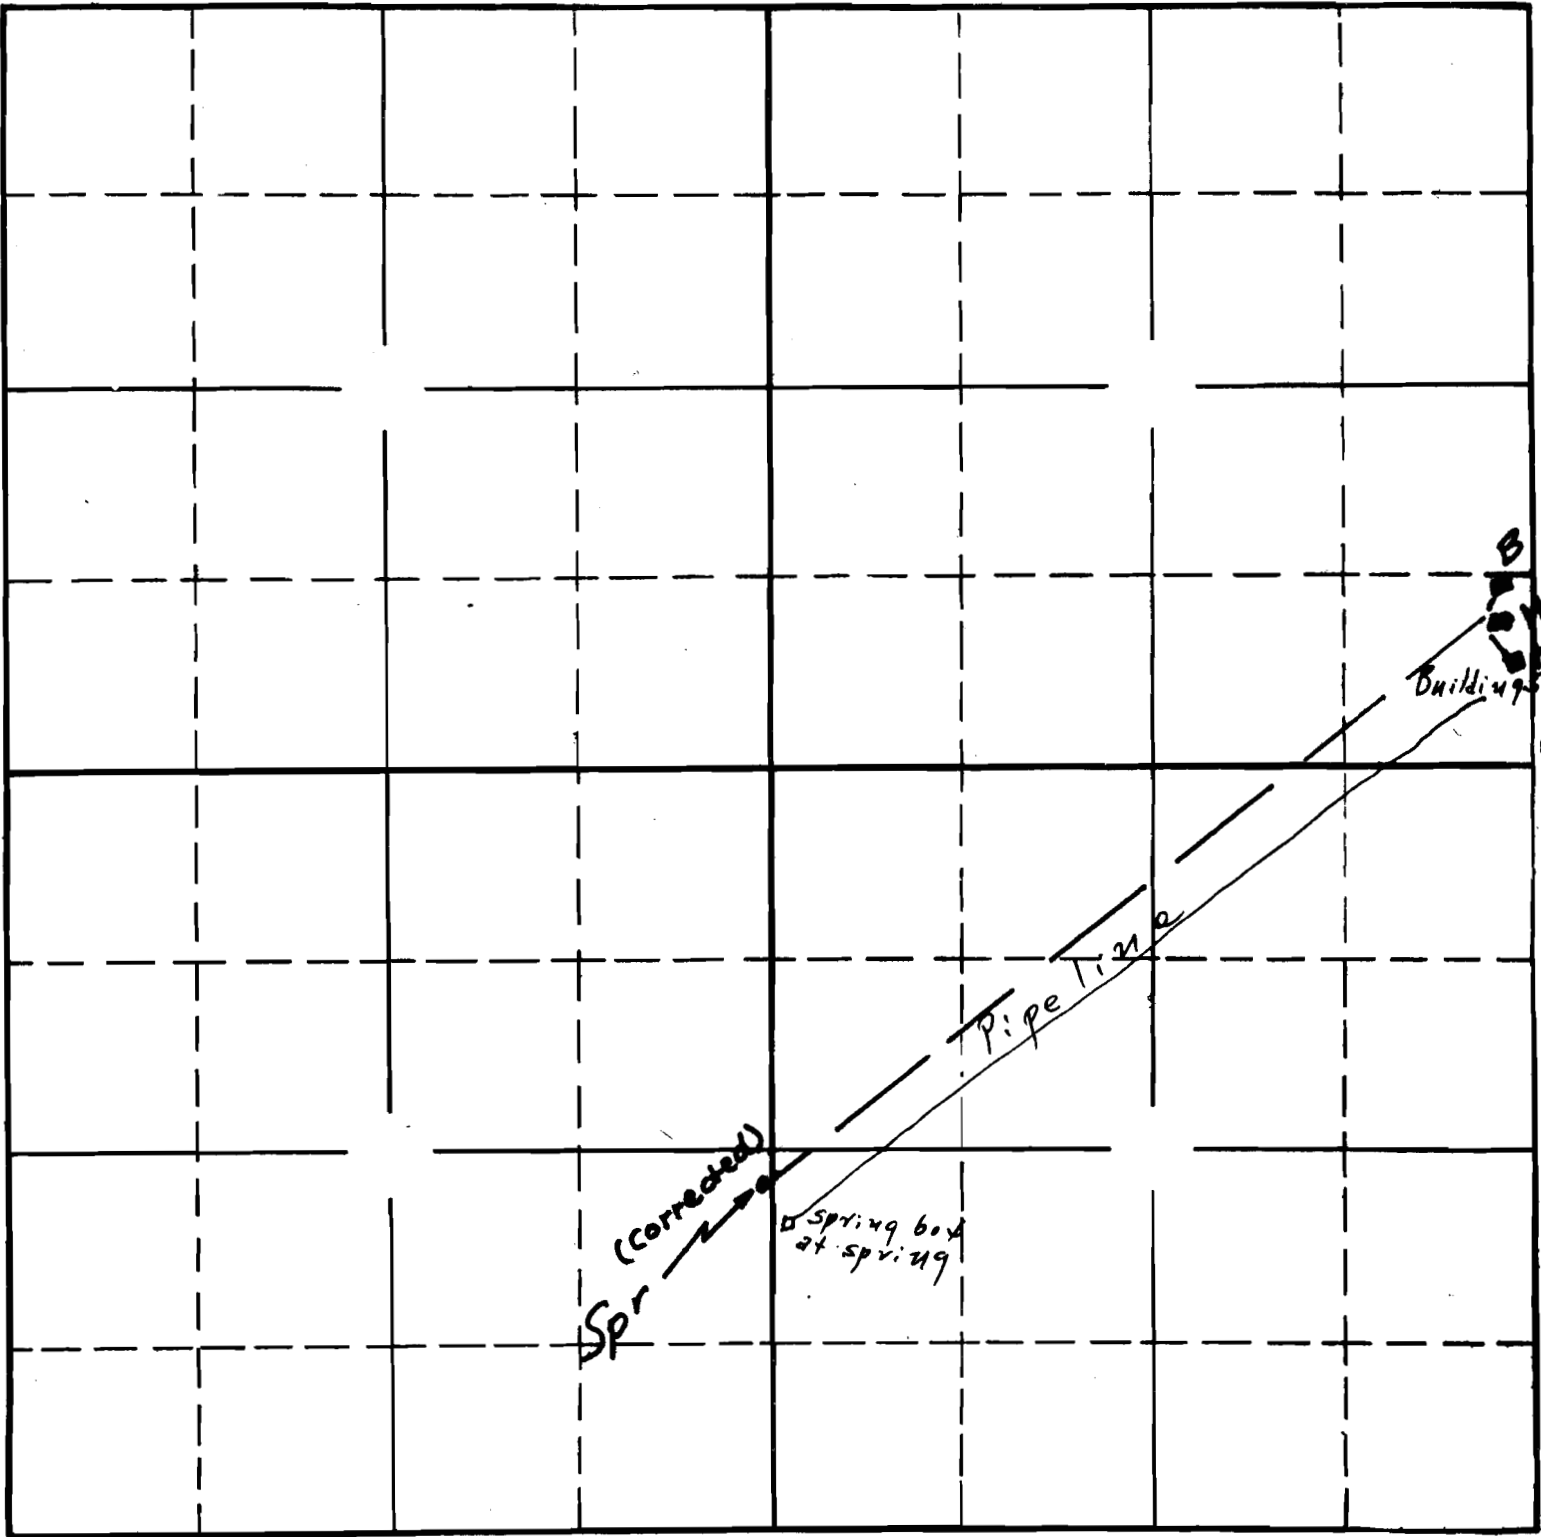

South

RECEIVED

MAR 7 1946

STATE ENGINEER  
SALEM, OREGON

APPLICATION No. 21460  
PERMIT No. 16835