


T. 1N & 1S. R. 26E. WM

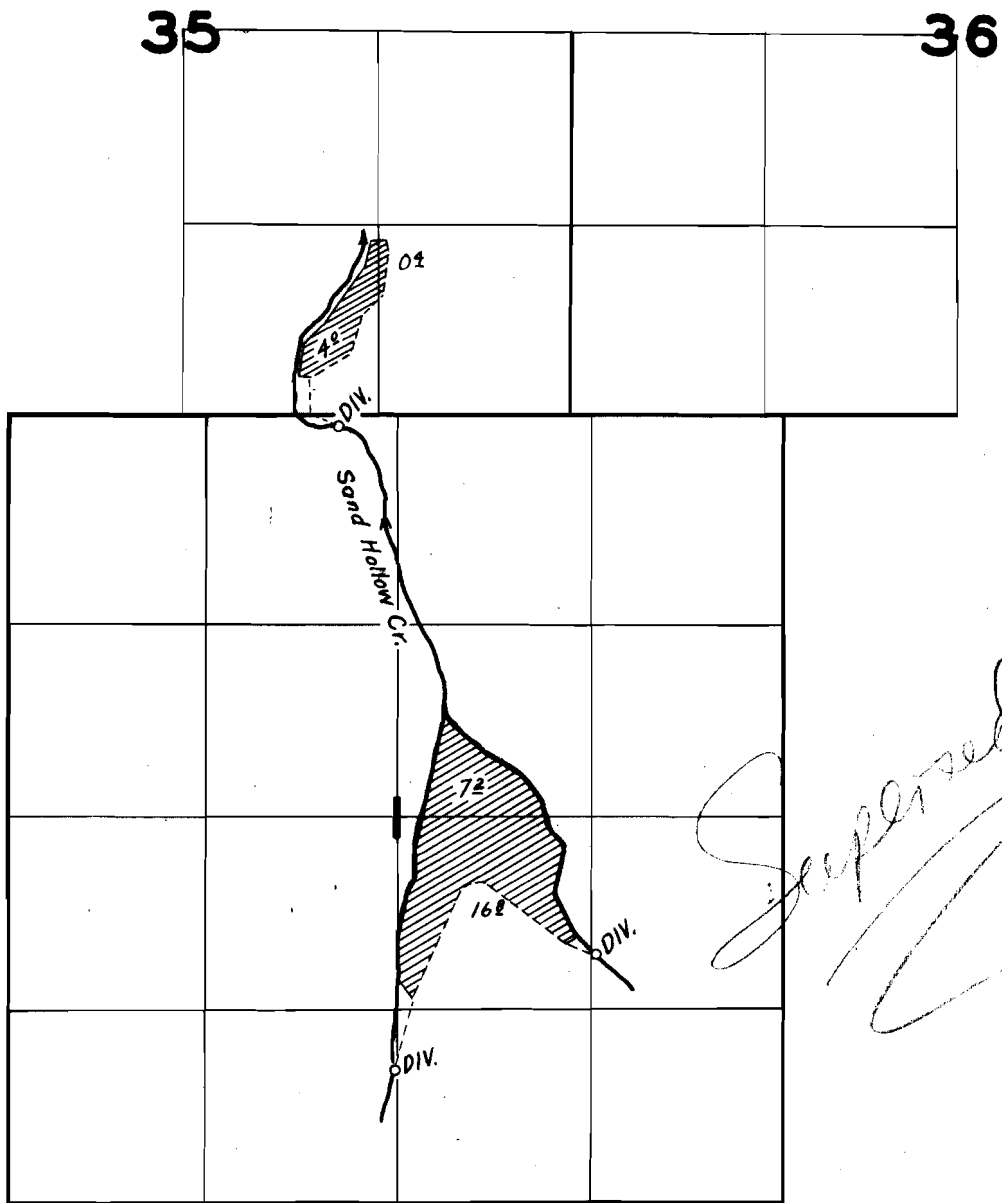

FINAL PROOF SURVEY

UNDER

Application No. 21582 Permit No. 16260

IN NAME OF


O.W. Cutsforth

Surveyed Apr 20 19 47, by J.E. Bunnell

T. 1N. & 1S. R. 26E. W.M.

35

36

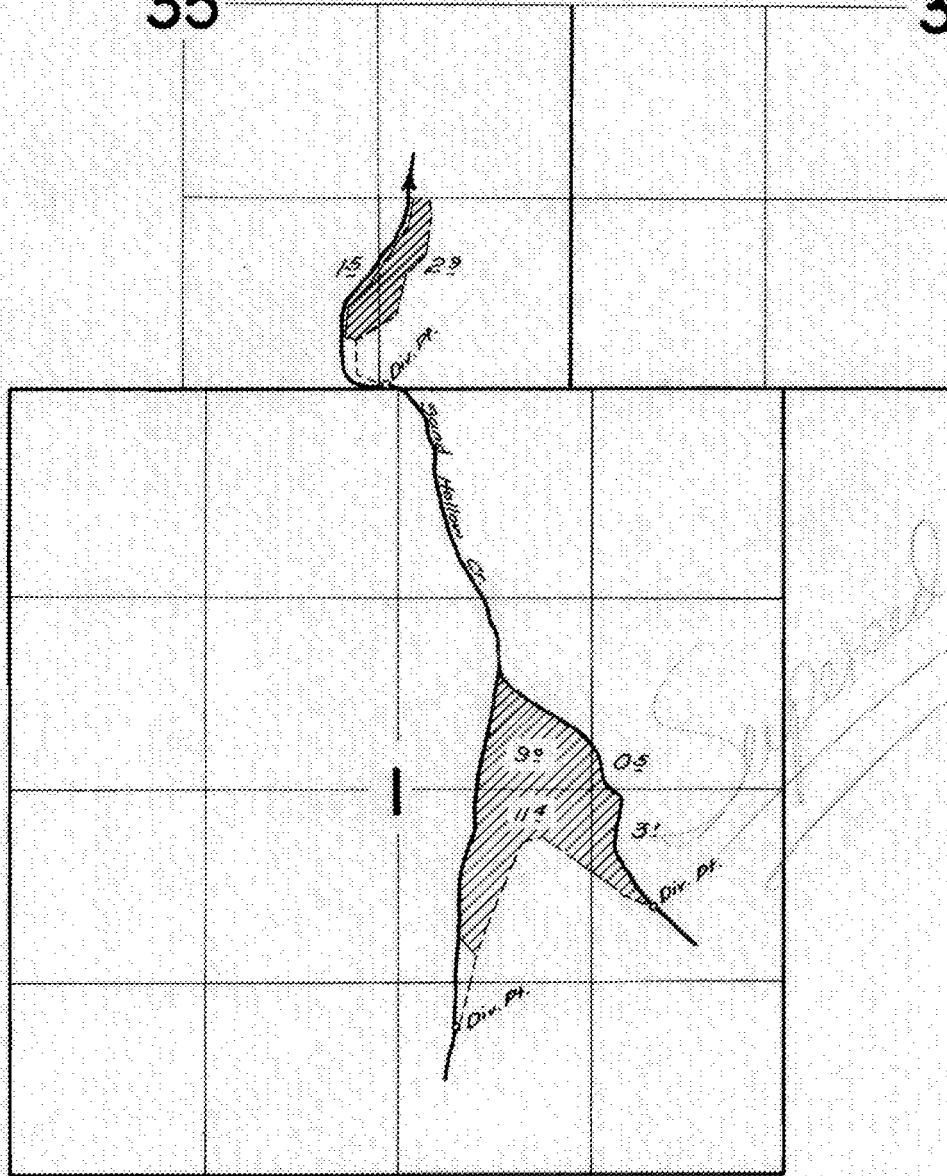


FINAL PROOF SURVEY UNDER

Application No. 21582 Permit No. 16960
IN NAME OF

O. W. CUTSFORTH

Surveyed April 20 1947, by J. E. Bunnell
October 10, 1961, by R. H. Jackson

T. 1S & N. R. 26E. W.M.

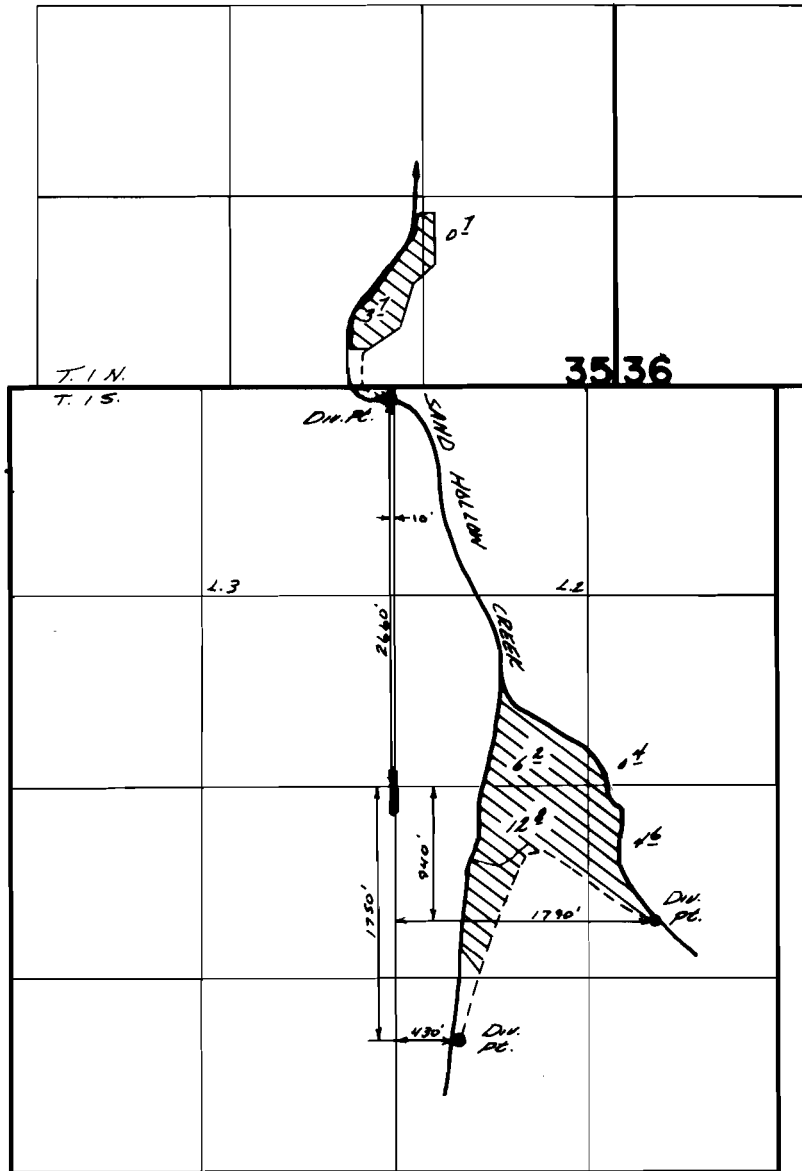

FINAL PROOF SURVEY UNDER

Application No. ~~21582~~.. Permit No. 16960.....
IN NAME OF

.....Q.W. CUTSFORTH.....

Surveyed April..20, 1947., by J.E. Bunnell.....
Oct. 10 1961 by R.H. Jackson