


U-191

17264 20935
C-22837

T.6N.R.35E.W.M.

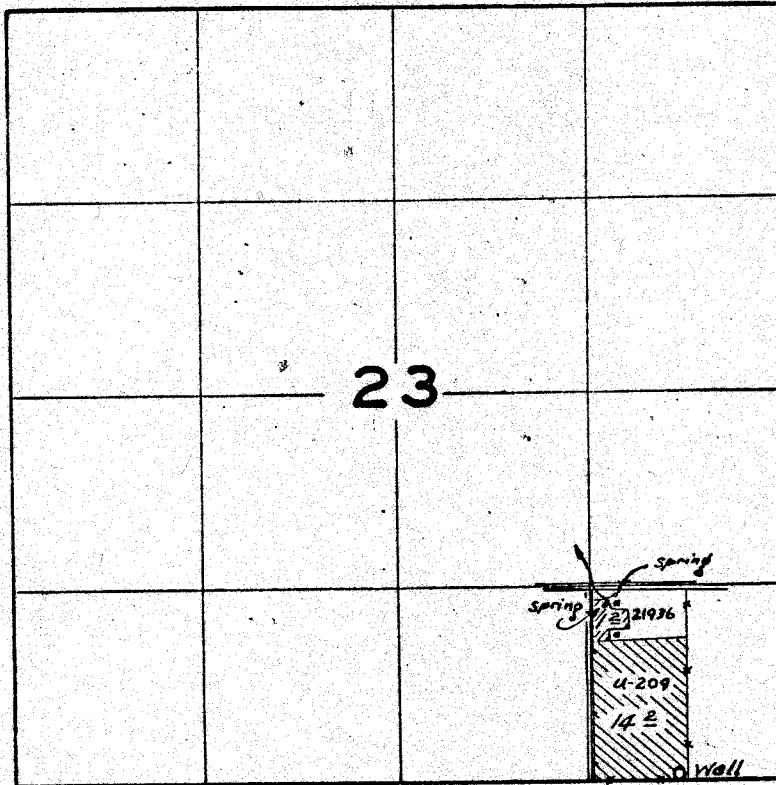

FINAL PROOF SURVEY

UNDER

U-209

U-191

Application No. 21936 Permit No. 17264

IN NAME OF

James P. Seitz

Surveyed May 11, 1951, by H. L. Coffman

NZ-5F-103