


SURVEYOR'S CERTIFICATE

I, W. E. Anderson County Surveyor of Tillamook Ore do hereby certify that this map was made from notes taken during an actual survey made by me on Oct 10-1950. that the monument shown on this map consisting of 2" Brass pipe with co-ordinates shown with reference to the S. E. Cor Sec 15. T. 14 N. R. 10. W. W. 11 Co Surv WE Anderson

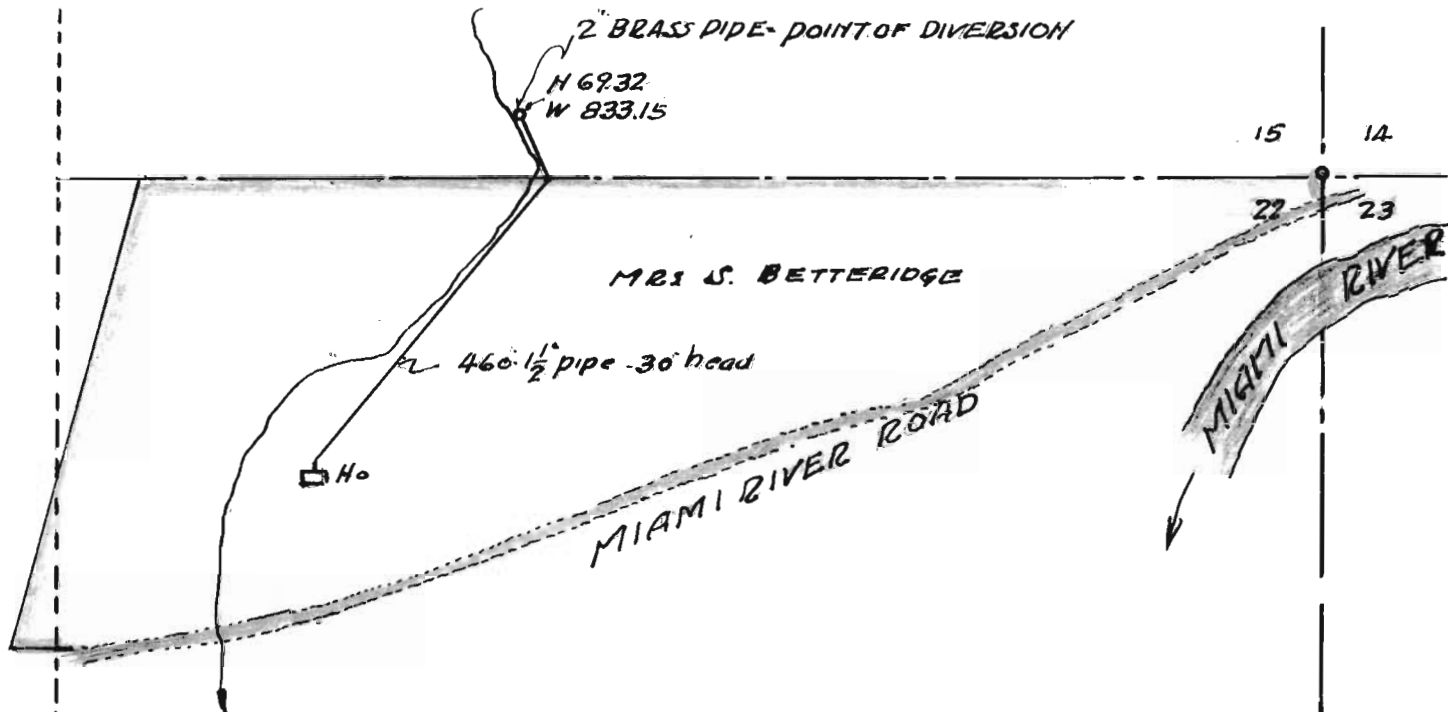

MRS. S. BETTERIDGE
LOCATED IN
SEC. 15 & 22 TWP. 14 N. R. 10 W. W. 11
TILLAMOOK ORE
SCALE 1"=200'

Application No. 25270
Permit No. 19853

WE Anderson