


# T17S R2WWM

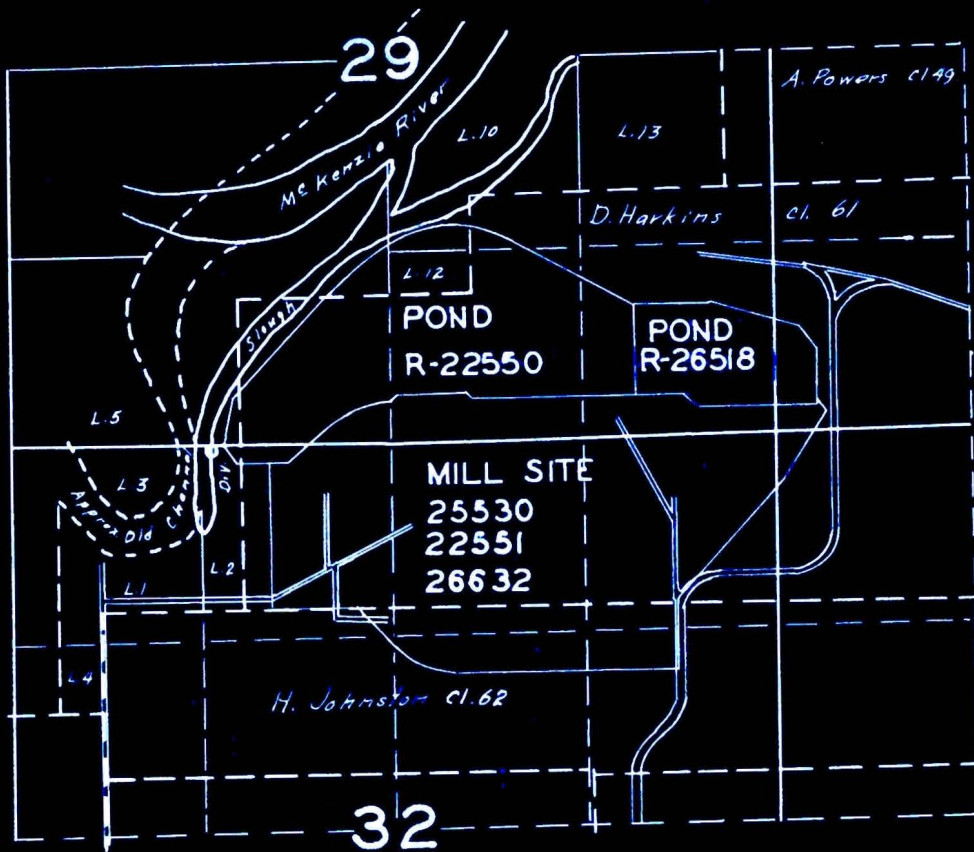

## FINAL PROOF SURVEY

UNDER

22551  
R-22550  
R-26518  
25530  
26632

Application No. \_\_\_\_\_ Permit No. \_\_\_\_\_  
IN NAME OF \_\_\_\_\_

17511  
R-861  
R-1265  
20053  
20864

Meyerhaeuser Timber Company

Surveyed April 22-1954, by T. Jones