


Per 14159
20951

T.10S.R.28E.W.M.

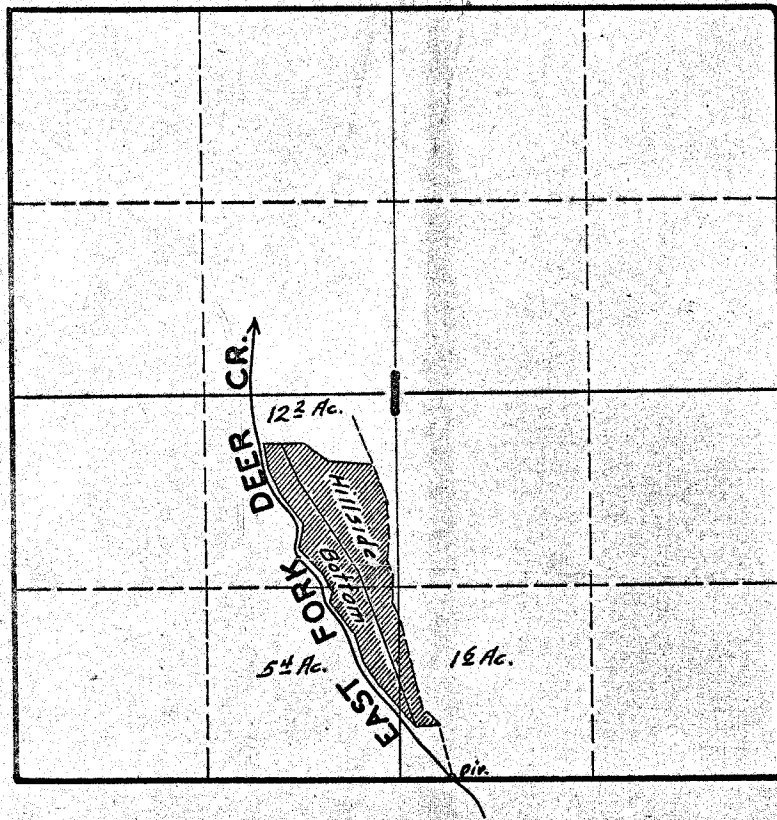

FINAL PROOF SURVEY
UNDER

Application No. 18500 Permit No. 14159

IN NAME OF

F.M. AKERS

Surveyed APR. 25 1946, by *James E. Sumrell*