# T.10S.R.4W.WM

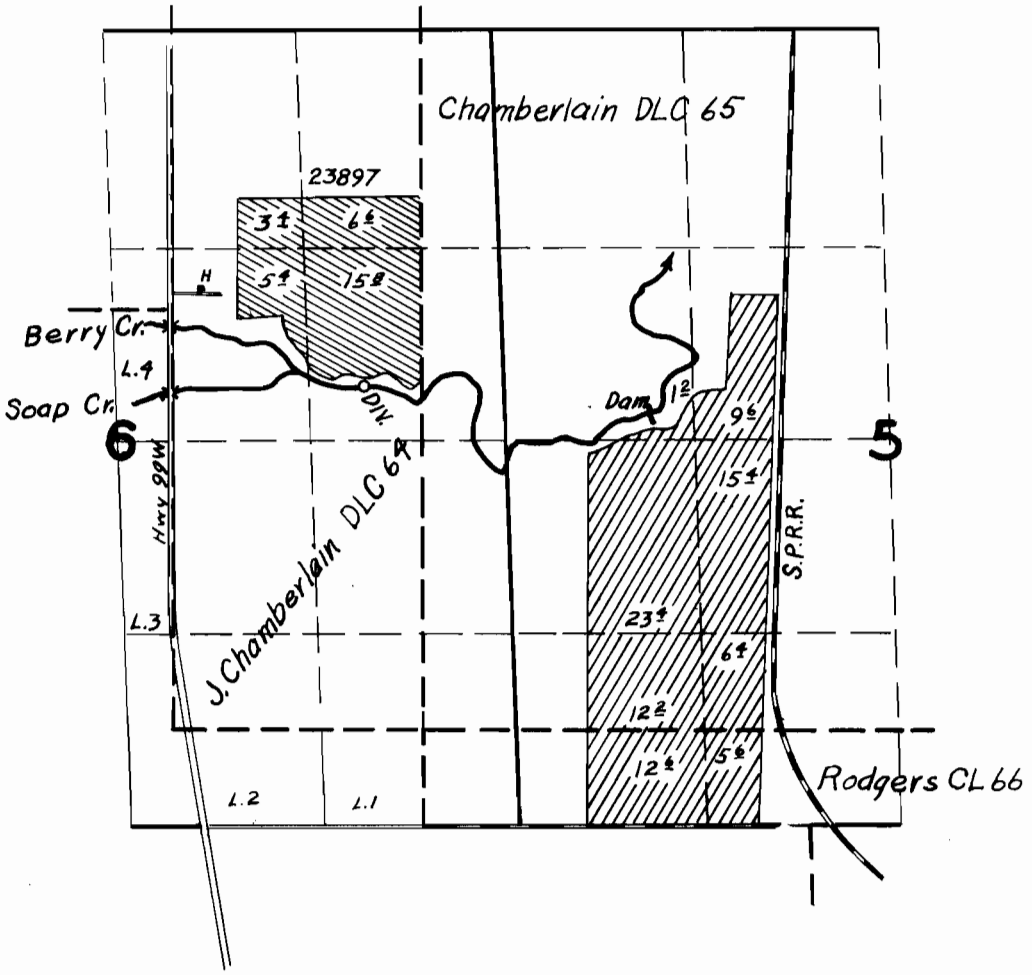


## FINAL PROOF SURVEY

23897 19332
22827 18044

Application No. R-22826 Permit No. R-911

IN NAME OF

George W. Gordon
Owen Cook

Surveyed Aug. 6 1954, by T. Jones

DFP-2D-115