


# T. 10S. R. 4W. WM

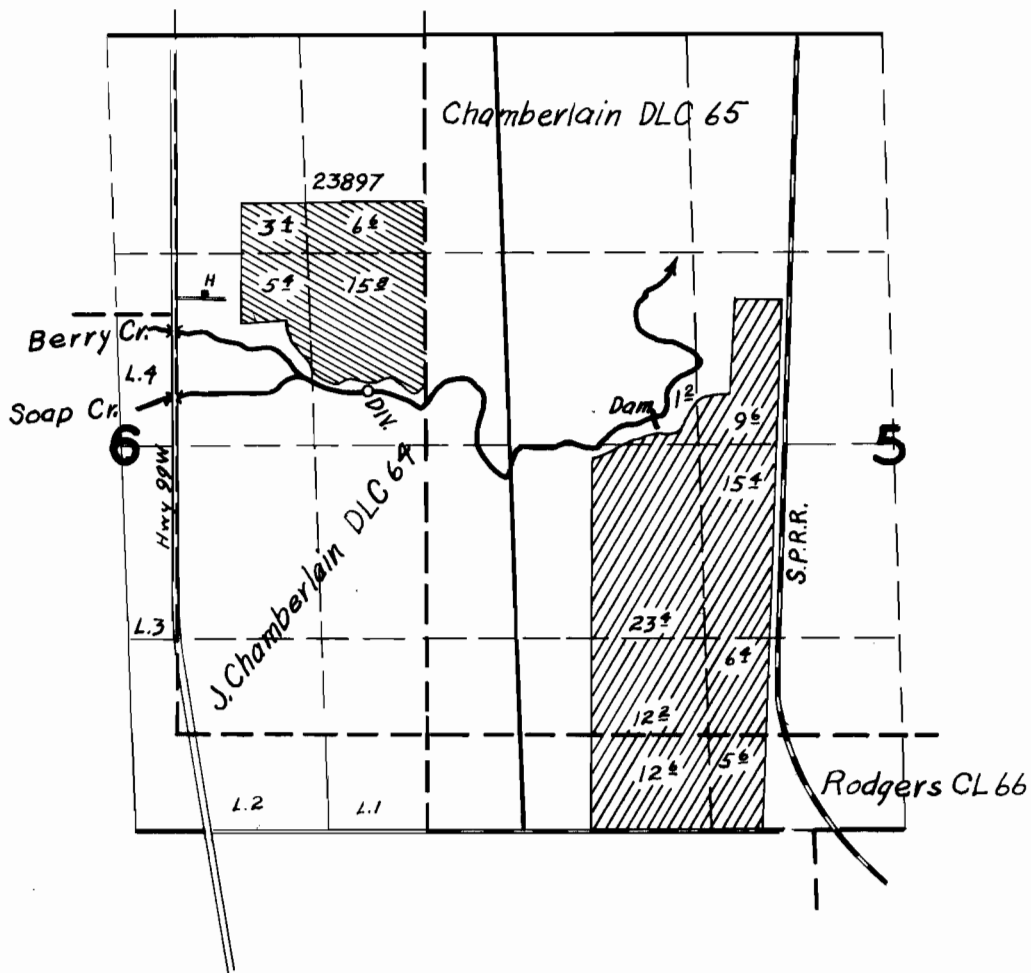

## FINAL PROOF SURVEY

23897 19332

22827 18044

Application No. ~~R-22826~~ Permit No. ~~R-911~~

IN NAME OF

George W. Gordon

Owen Cook

Surveyed Aug. 6, 1954, by T. Jones

DFP-2D-115