


T.18 S.R.3 W.W.M.

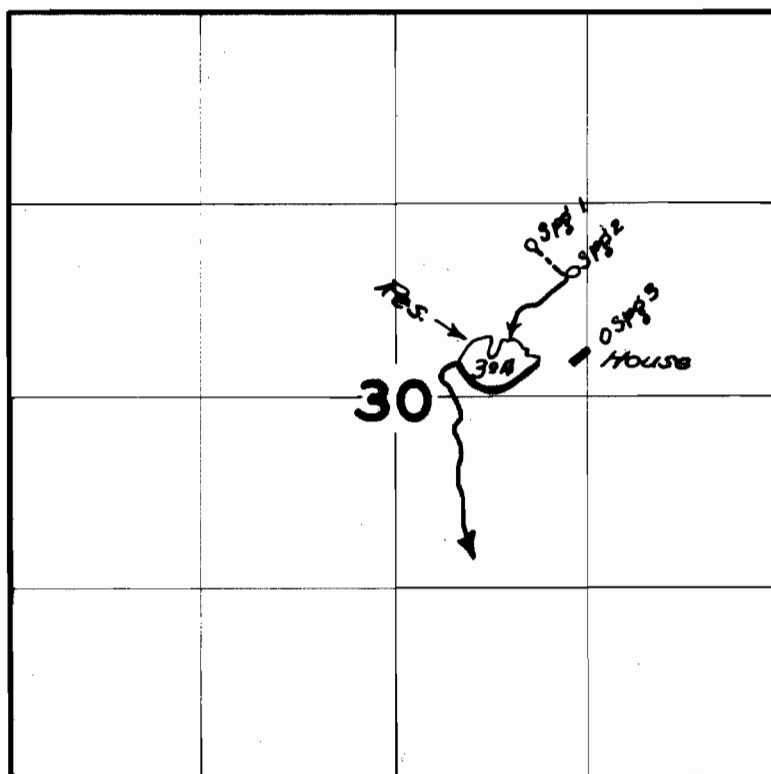

FINAL PROOF SURVEY

UNDER

23799

18771

Application No. R-23798 Permit No. R-973

IN NAME OF

D. Stephenson

Surveyed May 4, 1954, by H. L. Coffman

DBQ-6H-204