


Per. 14242
20959

T.9S.R.30E.W.M.

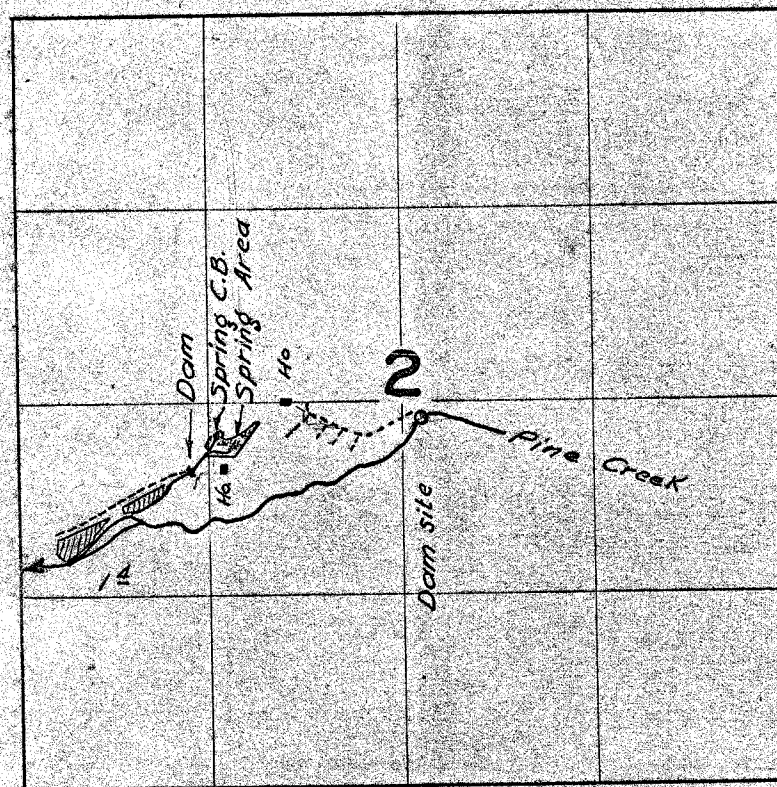

FINAL PROOF SURVEY
UNDER

Application No. 18584 Permit No. 14242
IN NAME OF

Elva Jackson

Surveyed Aug. 26, 1954, by H. L. Coffman