


T.12S.R.4W.WM

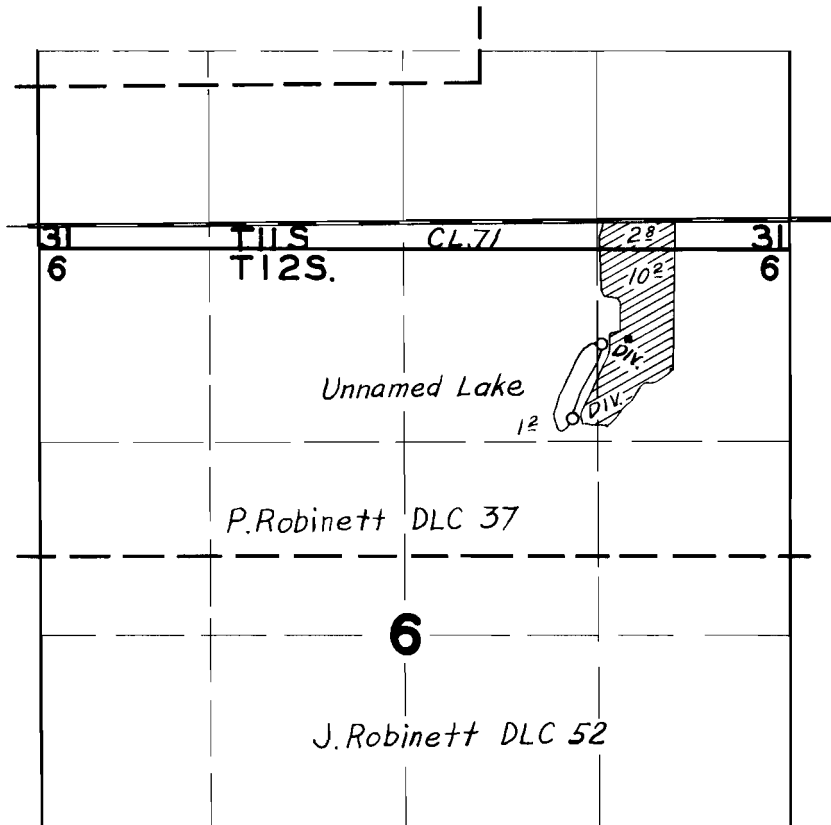

FINAL PROOF SURVEY UNDER

Application No. 19019 Permit No. 14629
IN NAME OF

Armine Cooper

Surveyed Aug. 2019 54, by H. L. Goffman.