


T.9S.R.3E.W.M.

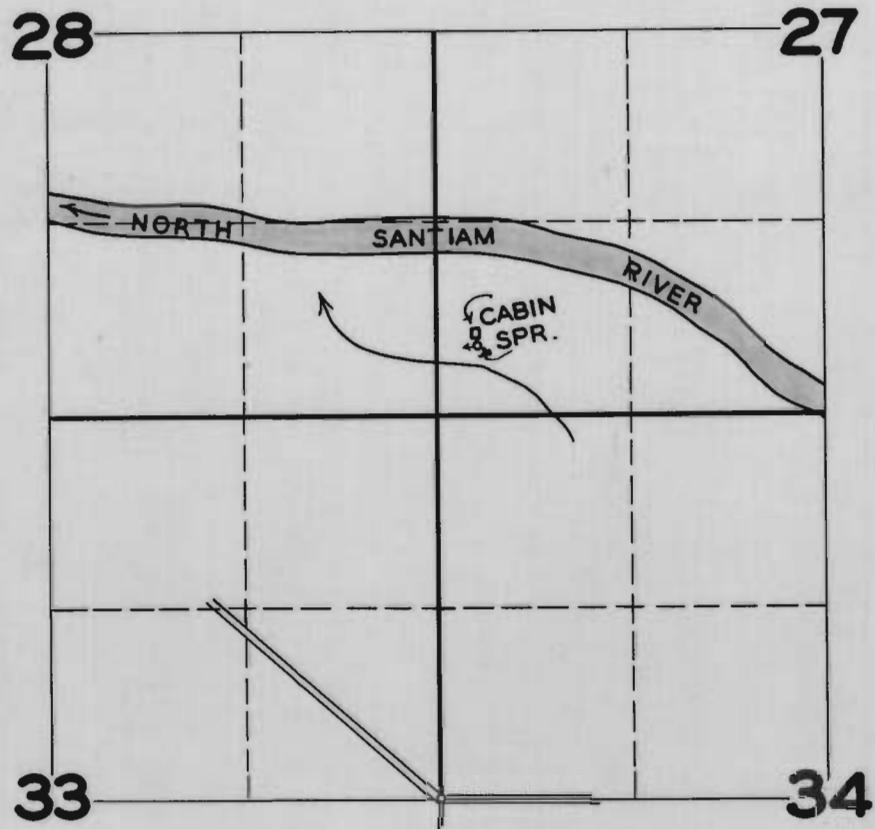

**FINAL PROOF SURVEY
UNDER**

Application No. 19238 Permit No. 14822

IN NAME OF

STUART FAGAN-REX SANFORD & E. J. KNUTSON

Surveyed MAY 26 1947, by JAS. E. BUNNELL