


T.9S.R.4W.WM

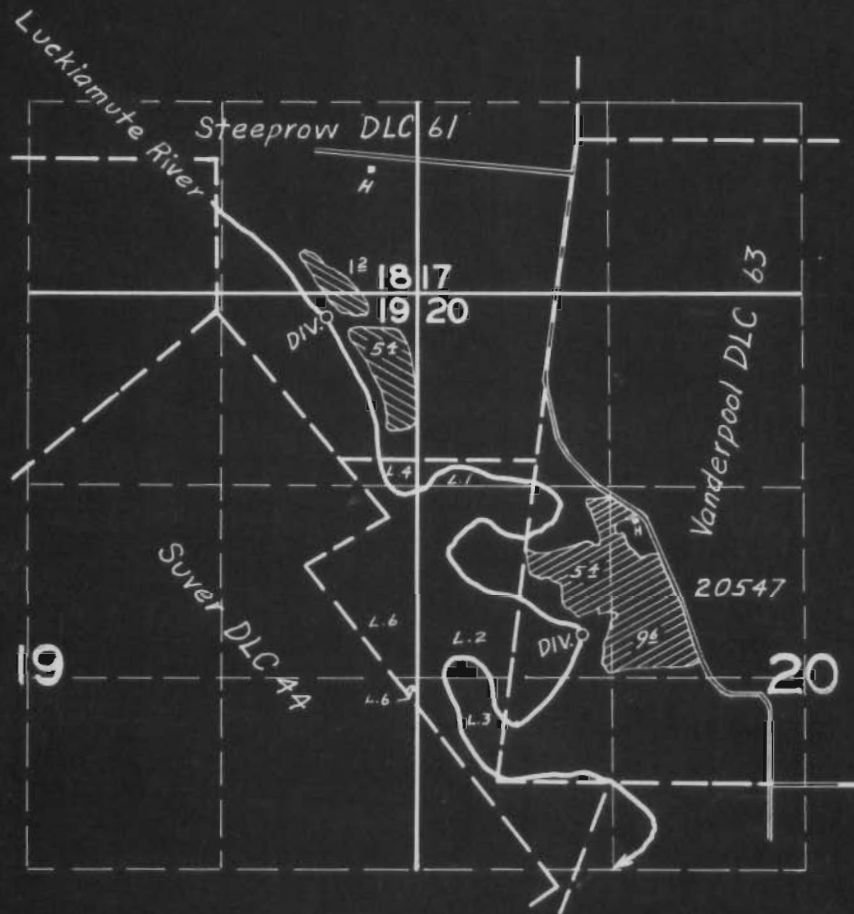

FINAL PROOF SURVEY

UNDER

20547 16041

Application No. 20791 Permit No. 16323

IN NAME OF

Paul E. Cook

Lester C. Cline

Surveyed Aug. 18, 1954, by T. Jones