


T.7S.R.3W.WM

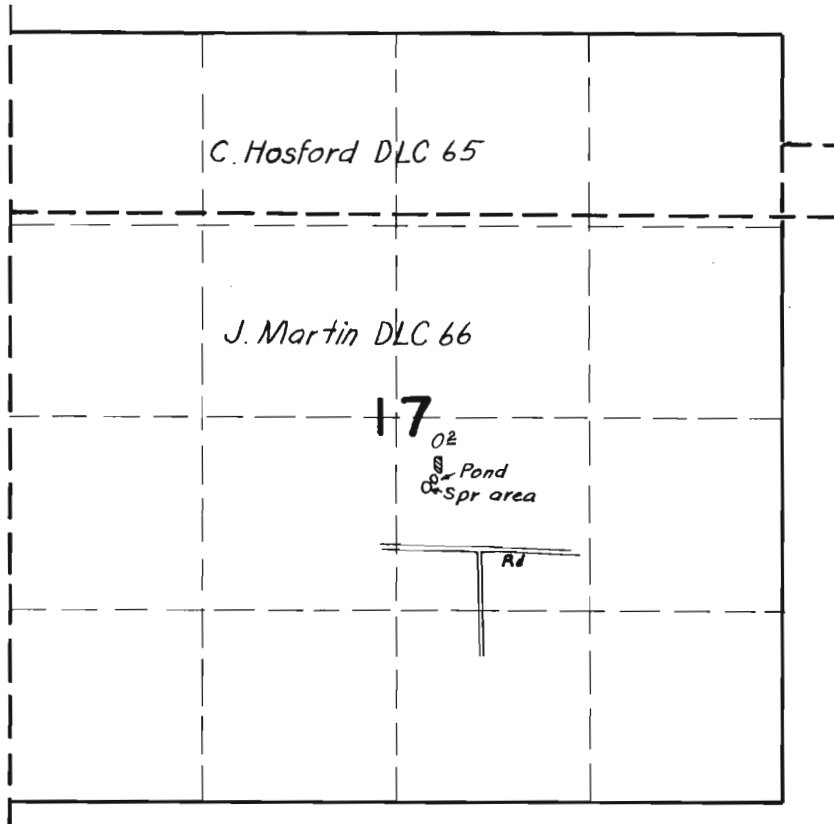

FINAL PROOF SURVEY UNDER

Application No. 21508 Permit No. 16931
IN NAME OF

Arthur H. Bone

Surveyed July 8 19 54 by T. Jones