


T.23S.R.32E.WM

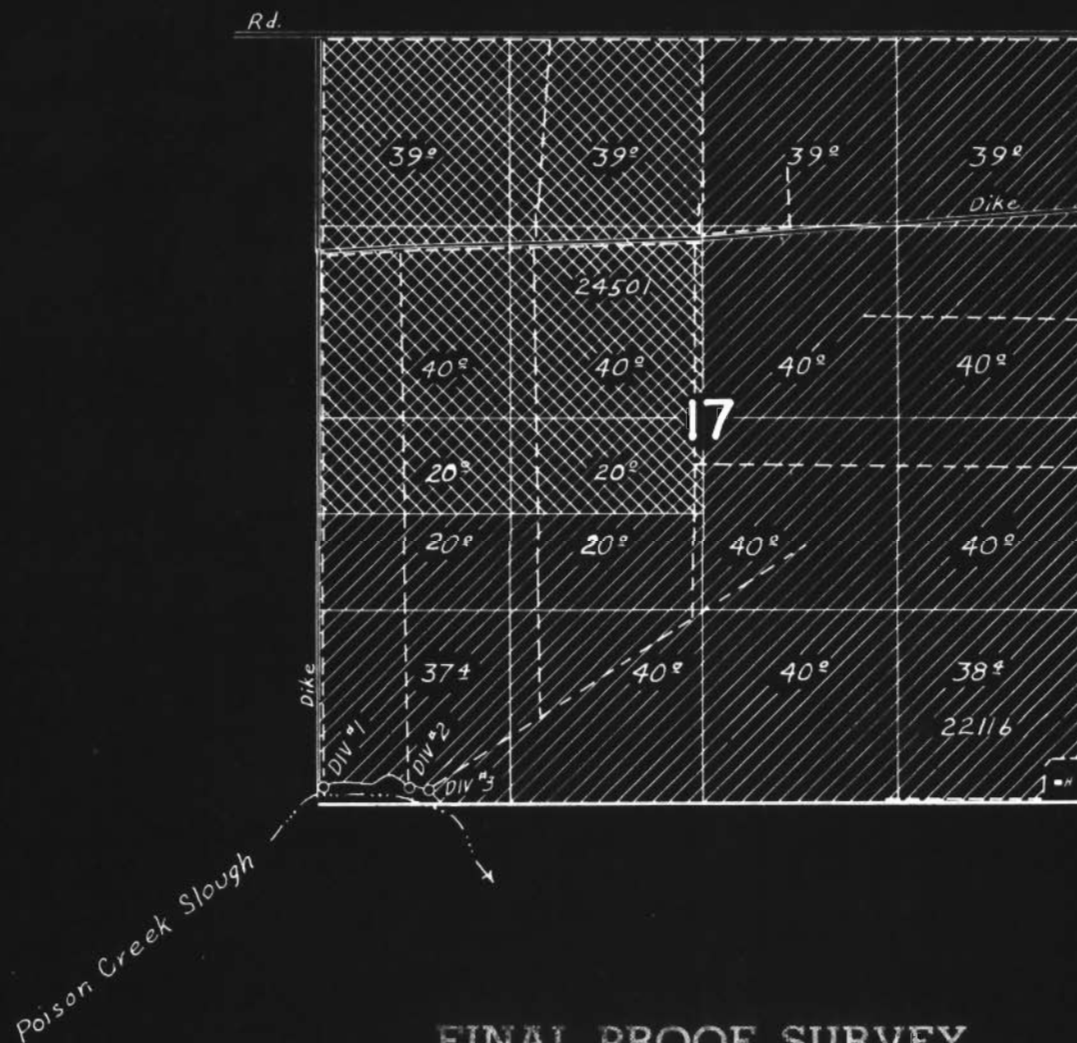

FINAL PROOF SURVEY

UNDER

24501

19299

Application No. 22116 Permit No. 17423

IN NAME OF

J. C. Clemens and Lotta J. Clemens

Surveyed June 29, 1954, by H. L. Coffman.

H2-6-12

H2-6-14