


# T.7S.R.5W.WM

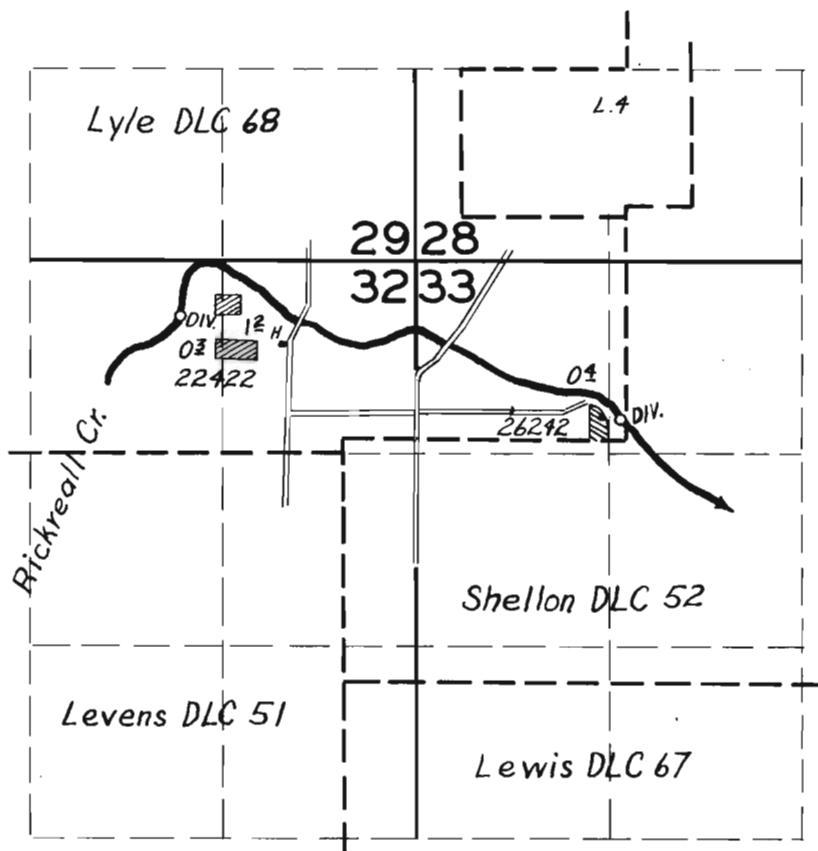

## FINAL PROOF SURVEY

UNDER

Application No. 22422 / 26242 Permit No. 17706 / 20995

IN NAME OF

John J. Fidler

George F. McBee

Surveyed Aug. 17, 1954, by T. Jones