


T.I.S.R.4W.W.M.

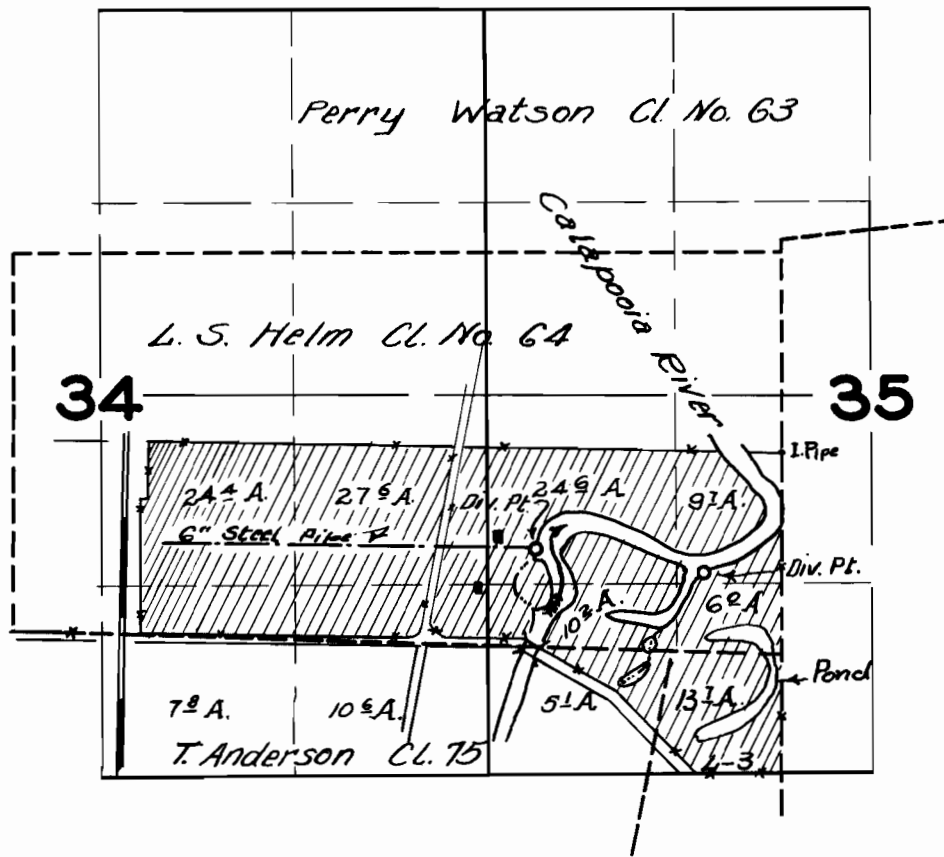

FINAL PROOF SURVEY

UNDER

Application No. 223.23 Permit No. 17601

IN NAME OF

W. H. BOTTEMILLER

Surveyed APR. 16, 1951, by H. L. COFFMAN