


T.27S.R.6W.W.M.

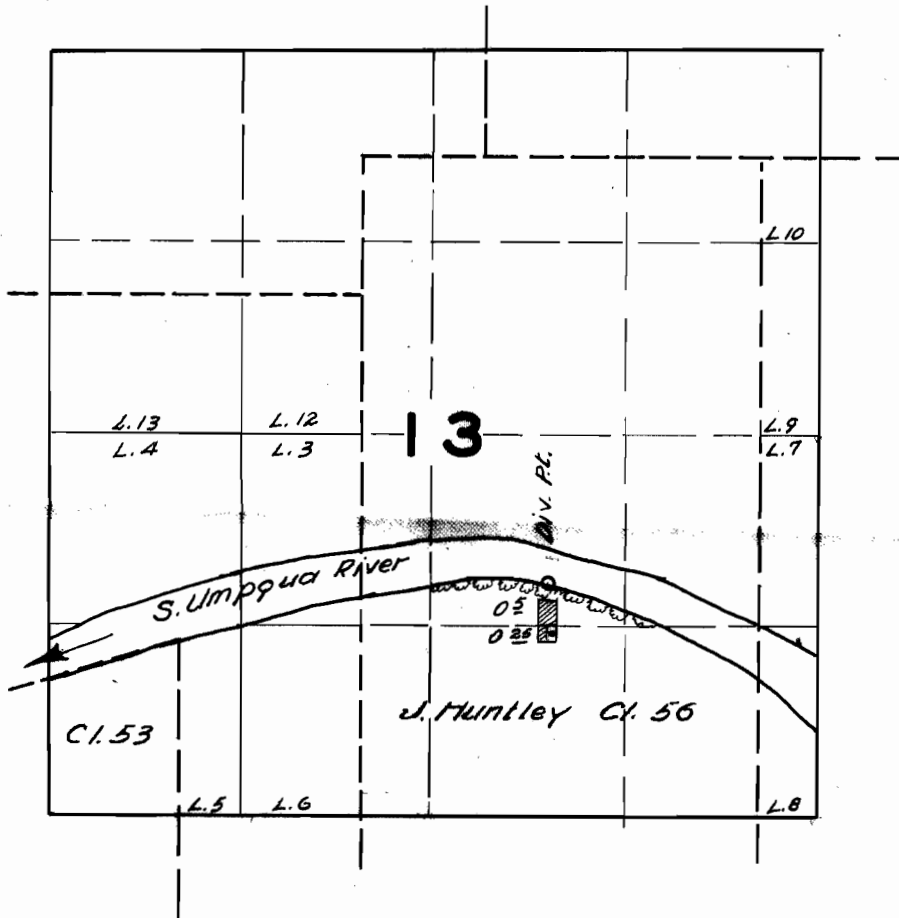

FINAL PROOF SURVEY UNDER

Application No. 22679 Permit No. 17838
IN NAME OF

Donald R. Gibbs

Surveyed May 14 1954, by H. L. Coffman