


T. 7S.R. 5 & 6 W.WM

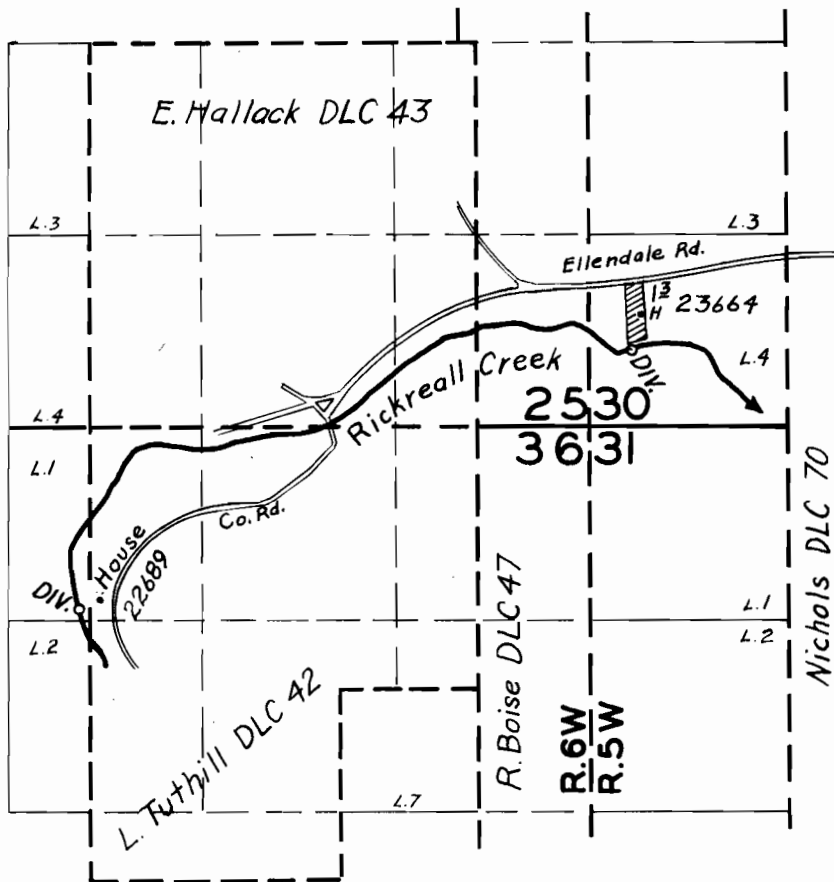

FINAL PROOF SURVEY

UNDER

Application No. 2367 Permit No. 1722

IN NAME OF

E. Hallack

of T. 7S. R. 5 & 6 W. WM

Surveyed 1917, by J. H. ...