


# T.10S.R.5W.WM

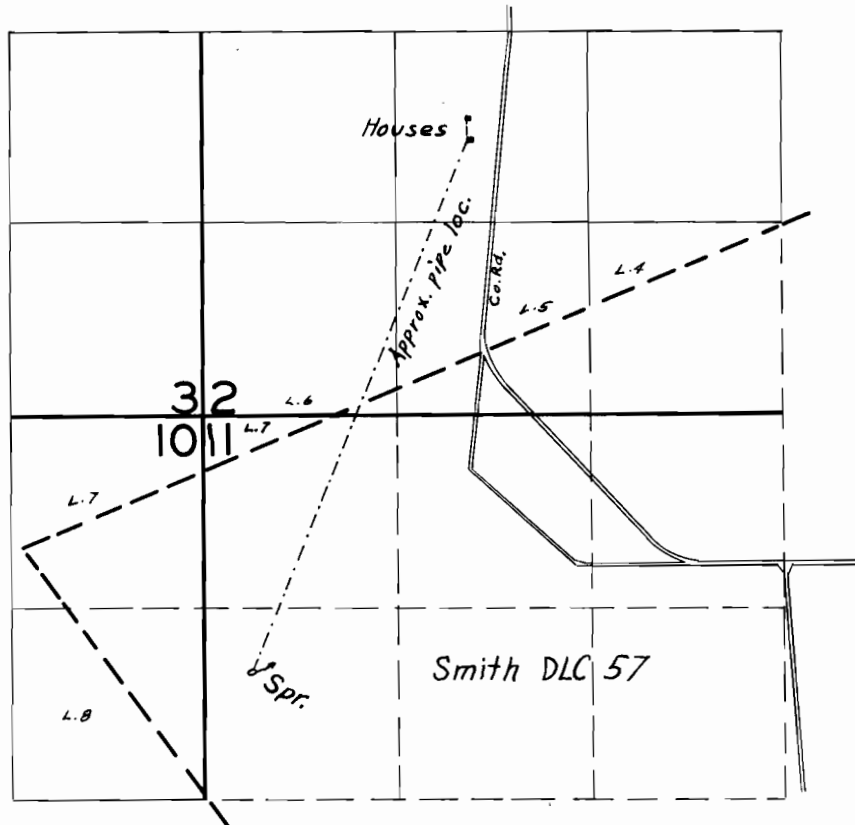

## FINAL PROOF SURVEY

UNDER

Application No. 22822 Permit No. 18042

IN NAME OF

Ralph Kester

Surveyed Aug. 18, 1954, by T. Jones

DFP-2D-177