


T.16S.R.6W. WM

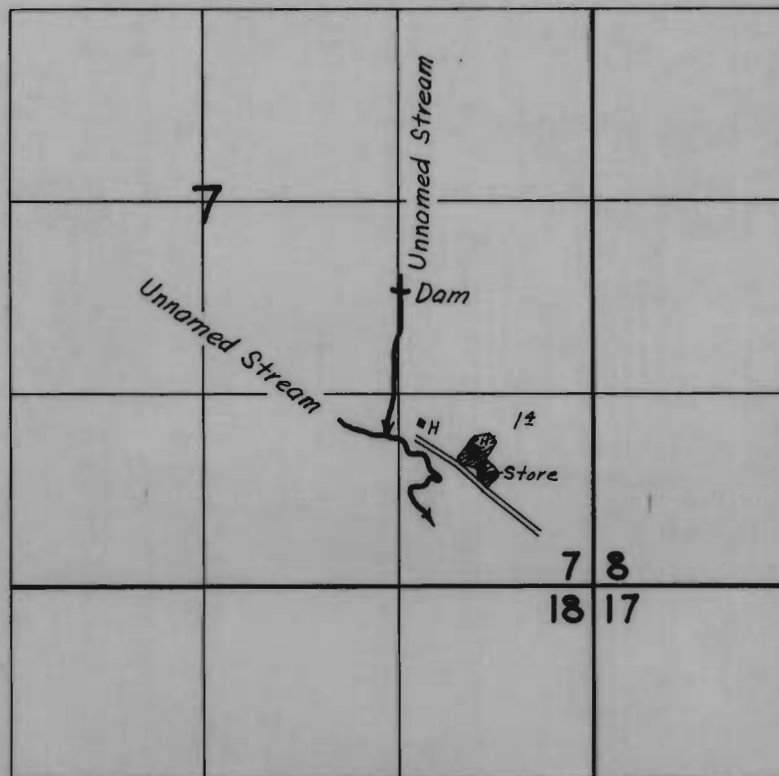

FINAL PROOF SURVEY
UNDER

Application No. 22842 Permit No. 18185
IN NAME OF

C. H. Erb and L. D. Huddleston

Surveyed April 22, 1954, by H. L. Coffman