
T.68 ., R.1 W ., W.M.

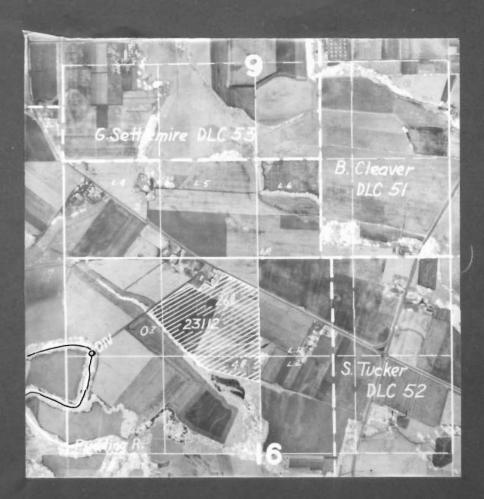

## FINAL PROOF SURVEY

UNDER

Application No. 23112 Permit No. 18218 IN NAME OF

A. P. Duda

Surveyed May 27 19 5h, by H. L. Coffman

DFN 2D 20h